


LOMR APP. MOUNTAINGATE SW RENO WHITES CREEK BRANCH 2

**APPLICATION FOR LETTER OF MAP REVISION (LOMR)
MOUNTAINGATE DEVELOPMENT
RENO, WASHOE COUNTY, NEVADA**

**PREPARED FOR
RYDER HOMES**

**PREPARED BY
QUAD KNOPF, INC.**

**JUNE 2006
JOB NUMBER 060212**

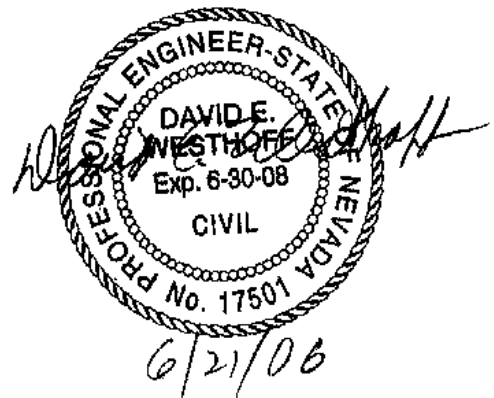

C. REVIEW FEE

Has the review fee for the appropriate request category been included?

Yes

Fee amount: \$4000

No, Attach Explanation

Please see the DHS-FEMA Web site at http://www.fema.gov/fhm/fhm_fees.shtml for Fee Amounts and Exemptions.

D. SIGNATURE

All documents submitted in support of this request are correct to the best of my knowledge. I understand that any false statement may be punishable by fine or imprisonment under Title 18 of the United States Code, Section 1001.

Name: David Westhoff

Company: Quad Knopf

Mailing Address:
9600 Prototype Court
Reno, NV 89521

Daytime Telephone No.:
775-324-1212

Fax No.:
775-324-2311

E-Mail Address: davidw@quadknopf.com

Signature of Requester (required):

David Westhoff

Date:

June 19, 2006

As the community official responsible for floodplain management, I hereby acknowledge that we have received and reviewed this Letter of Map Revision (LOMR) or conditional LOMR request. Based upon the community's review, we find the completed or proposed project meets or is designed to meet all of the community floodplain management requirements, including the requirement that no fill be placed in the regulatory floodway, and that all necessary Federal, State, and local permits have been, or in the case of a conditional LOMR, will be obtained. In addition, we have determined that the land and any existing or proposed structures to be removed from the SFHA are or will be reasonably safe from flooding as defined in 44CFR 65.2(c), and that we have available upon request by FEMA, all analyses and documentation used to make this determination.

Community Official's Name and Title: Steve Varela, Director of Public Works, City of Reno

Telephone No.:
775-334-2350

Community Name: City of Reno

Community Official's Signature (required):

Steve Varela

Date:

7/31/06

CERTIFICATION BY REGISTERED PROFESSIONAL ENGINEER AND/OR LAND SURVEYOR

This certification is to be signed and sealed by a licensed land surveyor, registered professional engineer, or architect authorized by law to certify elevation information. All documents submitted in support of this request are correct to the best of my knowledge. I understand that any false statement may be punishable by fine or imprisonment under Title 18 of the United States Code, Section 1001.

Certifier's Name:

Jeff Bracke

License No.:

8658

Expiration Date:

12/31/06

Company Name:

PLACES, CSI

Telephone No.:

775-355-7721

Fax No.:

775-355-7795

Signature:

Jeff Bracke

Date:

06/20/06

Ensure the forms that are appropriate to your revision request are included in your submittal.

Form Name and (Number)

Required if ...

- Riverine Hydrology and Hydraulics Form (Form 2) New or revised discharges or water-surface elevations
- Riverine Structures Form (Form 3) Channel is modified, addition/revision of bridge/culverts, addition/revision of levee/floodwall, addition/revision of dam
- Coastal Analysis Form (Form 4) New or revised coastal elevations
- Coastal Structures Form (Form 5) Addition/revision of coastal structure
- Alluvial Fan Flooding Form (Form 6) Flood control measures on alluvial fans

Seal (Optional)

C. REVIEW FEE

Has the review fee for the appropriate request category been included?

Yes

Fee amount: \$4000

No, Attach Explanation

Please see the DHS-FEMA Web site at http://www.fema.gov/fhm/firm_fees.shtm for Fee Amounts and Exemptions.

D. SIGNATURE

All documents submitted in support of this request are correct to the best of my knowledge. I understand that any false statement may be punishable by fine or imprisonment under Title 18 of the United States Code, Section 1001.

Name: David Westhoff

Company: Quad Knopf

Mailing Address:
9600 Prototype Court
Reno, NV 89521

Daytime Telephone No.:
775-324-1212

Fax No.:
775-324-2311

E-Mail Address: davidw@quadknopf.com

Signature of Requester (required):

David Westhoff

Date:

June 19, 2006

As the community official responsible for floodplain management, I hereby acknowledge that we have received and reviewed this Letter of Map Revision (LOMR) or conditional LOMR request. Based upon the community's review, we find the completed or proposed project meets or is designed to meet all of the community floodplain management requirements, including the requirement that no fill be placed in the regulatory floodway, and that all necessary Federal, State, and local permits have been, or in the case of a conditional LOMR, will be obtained. In addition, we have determined that the land and any existing or proposed structures to be removed from the SFHA are or will be reasonably safe from flooding as defined in 44CFR 65.2(c), and that we have available upon request by FEMA, all analyses and documentation used to make this determination.

Community Official's Name and Title: Steve Varela, Director of Public Works, City of Reno

Telephone No.:
775-334-2350

Community Name: City of Reno

Community Official's Signature (required):

Steve Varela

Date:

7/31/06

CERTIFICATION BY REGISTERED PROFESSIONAL ENGINEER AND/OR LAND SURVEYOR

This certification is to be signed and sealed by a licensed land surveyor, registered professional engineer, or architect authorized by law to certify elevation information. All documents submitted in support of this request are correct to the best of my knowledge. I understand that any false statement may be punishable by fine or imprisonment under Title 18 of the United States Code, Section 1001.

Certifier's Name:

Jell Brooke

License No.:

8658

Expiration Date:

12/31/06

Company Name:

PLACES, CSI

Telephone No.:

775-355-7721

Fax No.:

775-355-7795

Signature:

Jell Brooke

Date:

06/20/06

Ensure the forms that are appropriate to your revision request are included in your submittal.

Form Name and (Number)

Required if ...

Riverine Hydrology and Hydraulics Form (Form 2) New or revised discharges or water-surface elevations

Riverine Structures Form (Form 3) Channel is modified, addition/revision of bridge/culverts, addition/revision of levee/floodwall, addition/revision of dam

Coastal Analysis Form (Form 4) New or revised coastal elevations

Coastal Structures Form (Form 5) Addition/revision of coastal structure

Alluvial Fan Flooding Form (Form 6) Flood control measures on alluvial fans

Seal (Optional)




PUBLIC WORKS DEPARTMENT

MEMORANDUM

DATE: July 27, 2006

TO: Steve Varela, Public Works Director 

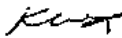FROM: Kerri Williams, Sanitary Engineering 

To SUBJECT: LOMR application for Mountaingate Community, by Ryder Homes, Southwest Reno, Whites Creek Branch near Arrowcreek.

Together with Chris Robinson of Community Development, we concur that this application for LOMR is in conformance with the approved development plans and with the approved Conditional LOMR. The channel as built and modeled will contain the 100 year flows and will remove specified sections from the floodplain and/or active floodway.

Your signature on FEMA for MT-2 is requested. Please return document to me for distribution.

TABLE OF CONTENTS

1.0 Introduction and Project Background	1
1.1 Introduction.....	1
1.2 Project Background.....	1
2.0 Existing Conditions.....	3
3.0 Hydrology	4
4.0 Hydraulic Analysis Of The Realigned Channel.....	5
5.0 Hydraulic Modeling Results	5
6.0 Findings.....	10
7.0 References.....	11

FIGURES

Figure 1 – Vicinity Map.....	2
Figure 2 – Looking northeasterly (downstream) of the realigned Whites Creek Branch 2...3	3
Figure 3 – Typical gabion drop structure	4
Figure 4 – Arrow Creek Parkway Box Culverts.....	6
Figure 5 – Arrow Creek Parkway Box Culverts.....	6
Figure 6 – Steamboat Ditch	6
Figure 7 – Existing FIRM.....	8
Figure 8 – Annotated FIRM.....	9

PLATES

Plate 1 – Hydraulic Workmap.....	7
Plate 2 – Hydraulic Workmap –Postdevelopment Conditions	7
As-Built Drawings (By Places Engineering)	App. C

APPENDICES

Appendix A – FEMA Forms and Attachments

Appendix B – HEC-RAS Output

Appendix C– As-Built Drawings (By Places Engineering)

1.0 INTRODUCTION AND PROJECT BACKGROUND

1.1 INTRODUCTION



Ryder Homes plans to develop the Dorostkar Property as the Mountaingate Project. The property is located in Section 20, T 18N. , R.20E. in Reno, Washoe County, Nevada (Figure 1). Whites Creek originates upstream of the project area in the Sierra Nevada Mountains near Mt. Rose. The upstream portions of the creek are deeply incised in a single channel. The creek diverges into 4 less defined channels (Branches 1 through 4) as it exits the steeper portions of the watershed (Section 30, T 18 N, R 20 E). Branches 2 and 3 cross the project site. Branch 3 will remain in its natural channel and with no modification, while Branch 2 will be diverted into a designed channel. Because no modifications are proposed for Branch 3 or its floodplain, this document focuses solely on Branch 2.

This application contains the information required for a Letter of Map Revision (LOMR) for the proposed Branch 2 channel. The FEMA forms and supplemental statements are attached as Appendix A. The hydraulic workmap showing the as-built condition of the channel is attached as Plate 1 (Appendix B).

1.2 PROJECT BACKGROUND

The Mountaingate project will be a residential community with +/- 225 residential units averaging 13,000 square feet (0.3 acre) in size. The project area is shown on Flood Insurance Rate Map (FIRM) 32031C 3170C. The Branch 2 and Branch 3 floodplains are designated Zone A while the remainder of the property is Zone X.


This report is a continuation of CLOMR Case Number **05-09-0503R**.

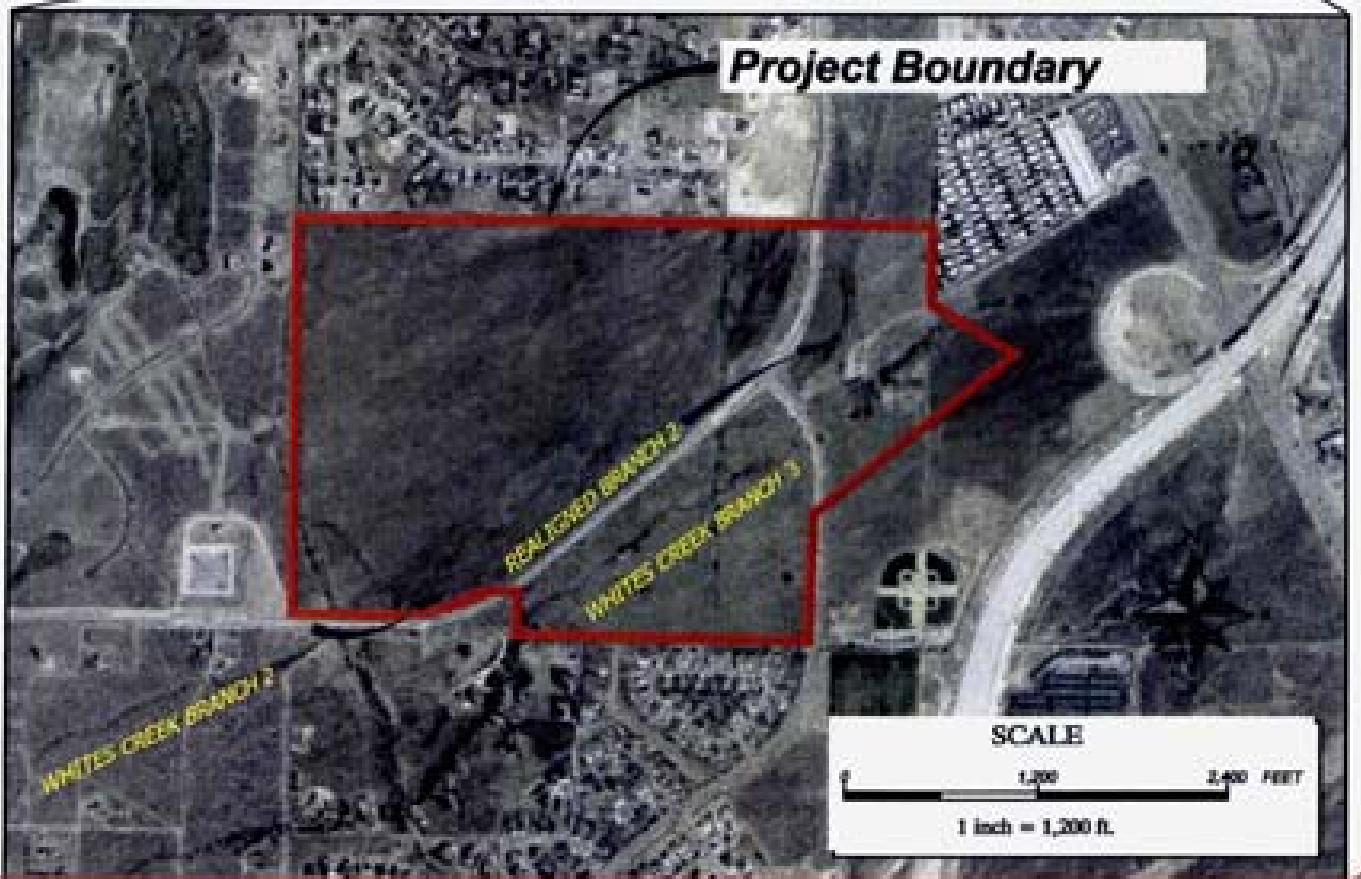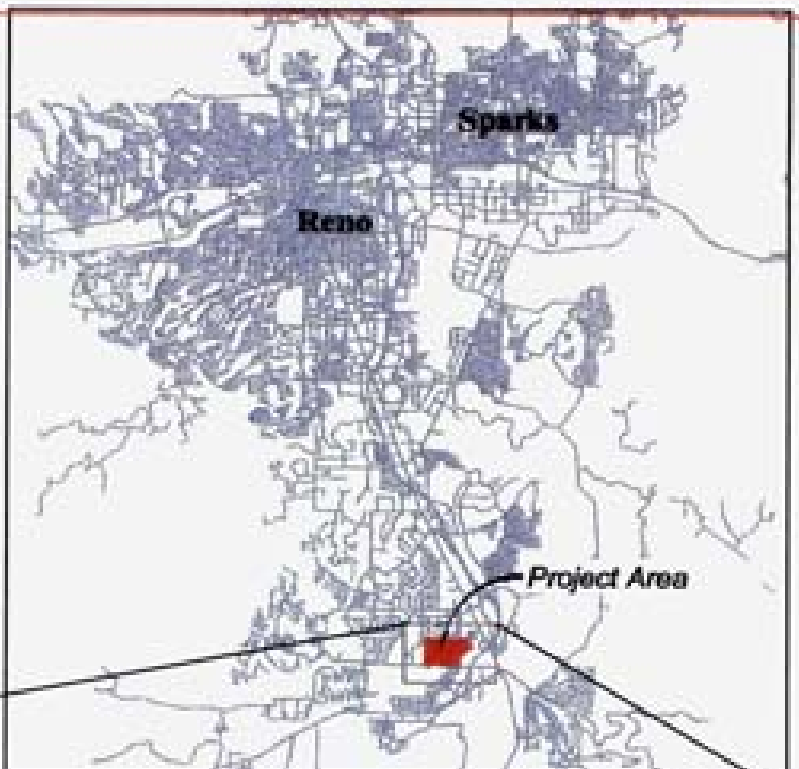

PLAT DATE:	June 2006
JOB NO.:	0060212
DWG. NAME:	0420_Domestic_RIO_v2006.dwg
SCALE:	As Noted
SHEET NO.:	2

IMPROVEMENT FOR:	Figure 1 Vicinity Map Mountaingate LOMP
Quad Knopf Job #0060212	Date: June, 2006

PREPARED BY:	8110 W. CYPRESS AVE. P.O. BOX 2688 MIDLAND, CA 95276 TEL: (505) 733-0440 FAX: (505) 733-7801
	
Quad Knopf	
DWG BY:	CHK BY:

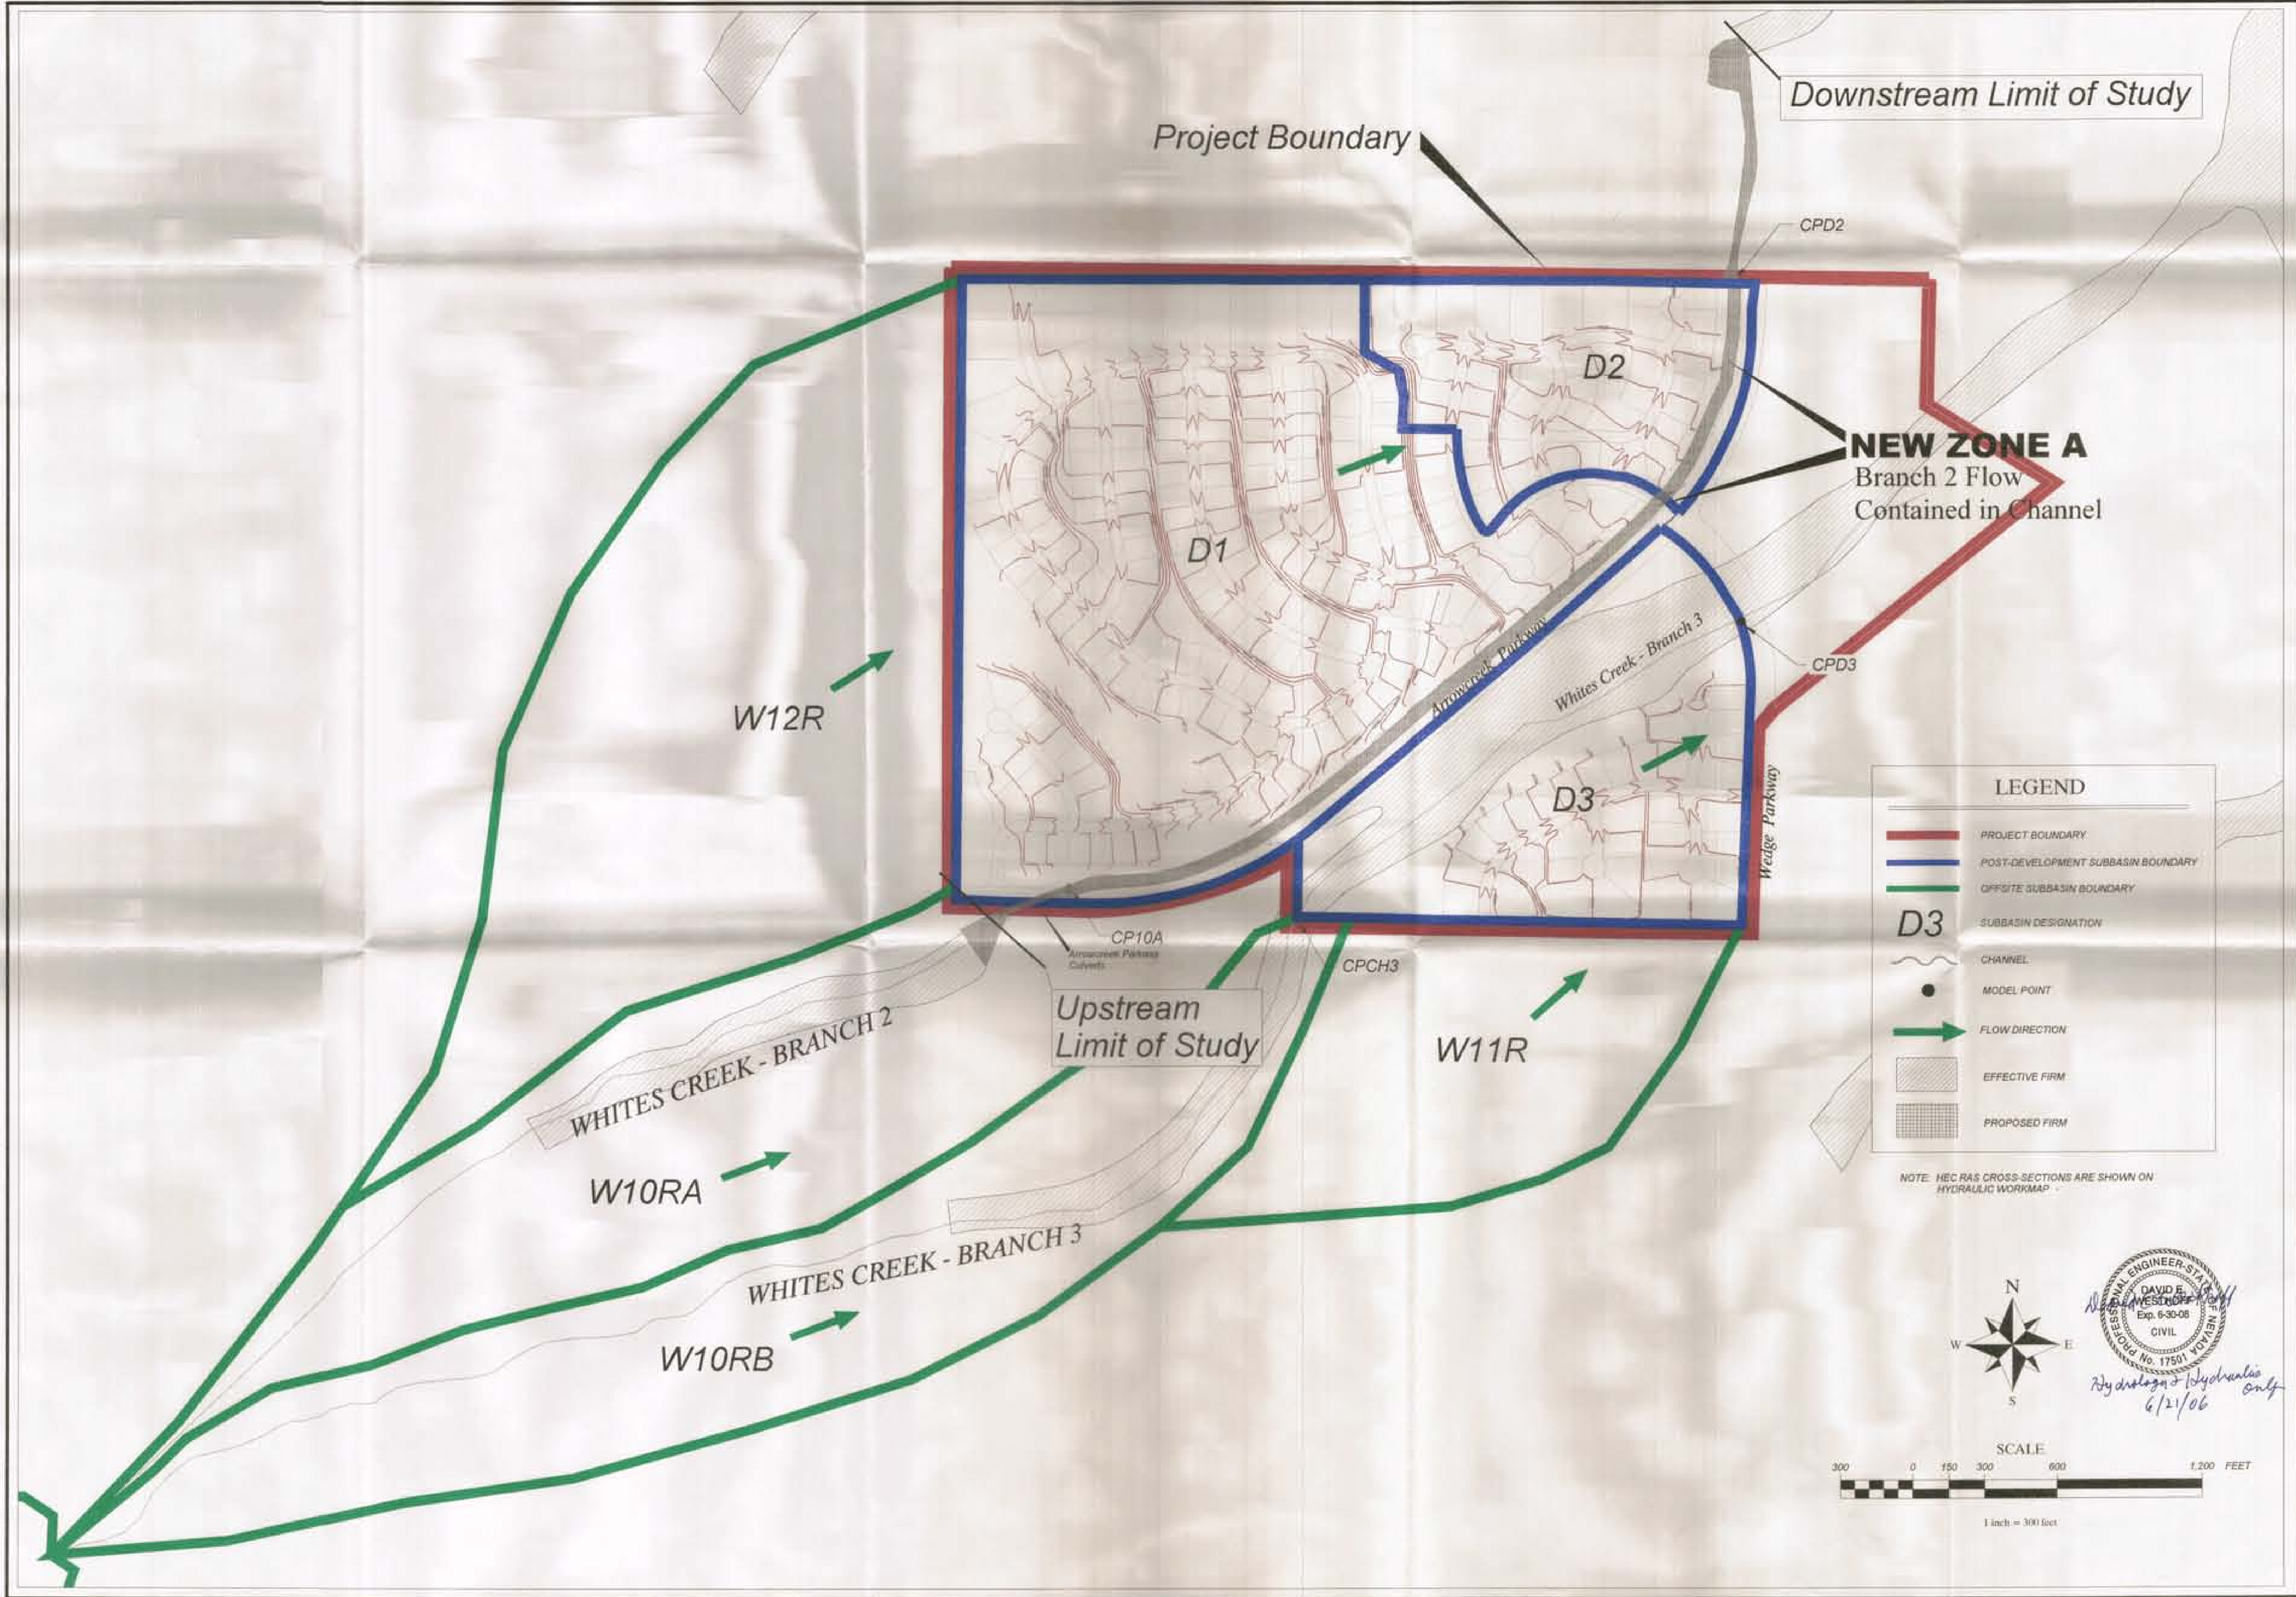

Downstream Limit of Study

Project Boundary

CPD2

NEW ZONE A
Branch 2 Flow
Contained in Channel

D1

D2

W12R

CPD3

Whites Creek - Branch 3

Wedge Parkway

D3

Upstream
Limit of Study

W11R

CP10A
Amarceek Park
Culverts

CPCH3

WHITES CREEK - BRANCH 2

W10RA

WHITES CREEK - BRANCH 3

W10RB

LEGEND

- PROJECT BOUNDARY
- POST-DEVELOPMENT SUBBASIN BOUNDARY
- OFFSITE SUBBASIN BOUNDARY
- D3 SUBBASIN DESIGNATION
- CHANNEL
- MODEL POINT
- FLOW DIRECTION
- EFFECTIVE FIRM
- PROPOSED FIRM

NOTE: HEC RAS CROSS-SECTIONS ARE SHOWN ON HYDRAULIC WORKMAP



PROFESSIONAL ENGINEER-STATE OF NEVADA
DAVID E. WESTGROFF
Exp. 6-30-08
CIVIL
Hydrology & Hydraulics only
6/21/06

9900 Prototype Ct.
Reno, Nevada 89521
TEL: (775) 334-1212
FAX: (775) 334-2011
WEB: www.quadknopf.com
10428

Quad Knopf

References: Proposed grading supplied by Mackay & Samps, Inc.

Date: _____

Revisions: _____

Scale: 1" = 300'
Date: June, 2006
File Name: 0428_topogrpdr_2005.dwg
Drawn By: GH
Designed By: DW

PLATE 2
TOPOGRAPHIC WORKMAP
POST-DEVELOPMENT CONDITIONS
Mountaingate LOMR

Sheet 1 of 1
Quad Knopf Job # 0428

2.0 EXISTING CONDITIONS

Whites Creek originates on the eastern side of the Carson Range in the Sierra Nevada Mountains. The contributing watershed extends to an elevation of over 10,600 feet. The upper reaches are primarily vegetated with pine trees and mountain mahogany brush, which transitions to sage brush, grasses, and suburban area in the lower reaches. Soils are largely in Hydrologic Soil Group C, and have corresponding relatively low infiltration rates.

At approximately elevation 5,000', Whites Creek diverges into four branches (the diffidence). Of these, Branches 2 and 3 pass through the Mountaingate property (Figure 1). Branch 3 will be left in its natural state, and is not a part of this study. Branch 2, however, has been realigned and designed to convey the 100-year flow. Channel improvements began where Branch 2 crosses under Arrow Creek Parkway in three ten foot wide by five foot tall box culverts. The channel slopes on average from three to four percent. Gabion drop structures have been incorporated along with geotextile fabric (details in Appendix C) to control flow velocities, as shown in Figures 2 and 3. Channel improvements end just north of the Mountaingate property boundary where the realigned Branch 2 merges with an existing channel (also the downstream boundary of this study). Channel improvements will be discussed further in Section 4.0.

Figure 2. Looking northeasterly (downstream) of the realigned Whites Creek Branch 2



Figure 3. Detail showing a typical gabion drop structure and geotextile lining, looking east (upstream). The three box culverts in the background are the Arrow Creek Parkway crossing.



3.0 HYDROLOGY

The hydrologic analysis for this project was covered in CLOMR Case Number **05-09-0503R**, *Application for Conditional Letter of Map Revision (CLOMR), Mountaingate Development, Reno Nevada* (Nimbus Engineers, 2005).

The 100-year, 24-hour flowrate for Whites Creek Branch 2 was determined to be 1123 cfs at the upstream boundary of this study, and 1144 cfs at Mountaingate's downstream property boundary (Nimbus Engineers, 2005).

4.0 HYDRAULIC ANALYSIS OF THE REALIGNED CHANNEL

The realigned Whites Creek Branch 2 channel (including the road crossings at Arrow Creek Parkway and Wedge Parkway) was modeled using the U.S. Army Corps of Engineers model HEC-RAS 3.1.3. This model was run in the mixed flow regime with initial conditions of critical depth at both upstream and downstream boundaries. As shown in CLOMR Case Number **05-09-0503R**, this channel was designed to capture and convey the 100-year, 24-hour storm event in order to modify effective FIRM 32031C3170E. Plate 1 shows the locations of model cross sections.

This realigned channel begins at three ten foot wide by five foot tall box culverts under Arrow Creek Parkway, and follows along the northwest side of Arrow Creek Parkway. The channel passes through three twelve foot wide by six foot tall box culverts under Wedge Parkway, and connects with an existing channel at the northeast corner of the property. Overall, approximately 6000 LF of improvements were made. Channel slope is typically three to four percent, and was lined with a turf-reinforced mat material rated for the velocities and shear stresses expected in the channel. Drop structures were constructed of gabions with 24-foot long scour holes.

5.0 HYDRAULIC MODELING RESULTS

As prepared for in its design, flow in Whites Creek Branch 2 is primarily supercritical for the length of the Mountaingate property. The average depth is four feet. During the 100-year event the velocity typically ranges from 8 to 13 feet per second, averaging about 11 feet per second, with peaks of up to 18 feet per second over the gabion drop structures. 18 ft/s

The cross section with the highest velocity occurs at 82+00 (Figures 4 and 5), just upstream of the box culverts at Arrow Creek Parkway. This is due to the steep drop in the channel in the approach to the box culverts (approximately ten feet). In addition to crossing under Arrow Creek Parkway, Whites Creek Branch 2 also passes under Steamboat ditch (Figure 6). While the velocity here may be high, the culvert approach is paved with concrete, and has large diameter ($D_{50} > 1'$) rip rap lining the channel before it. At the downstream end of the channel, the velocity will be reduced to just over four feet per second prior to leaving the project site. This channel will convey 1144 cfs with a minimum 1.0 feet of freeboard.

HEC-RAS model results are summarized in Appendix B. The channel profile in Appendix B does not include the box culverts under Arrow Creek (and the channel upstream) due to the computational limitations in HEC-RAS. These three box culverts were all built with slightly different invert elevations, and flow passes through each in the supercritical regime. As stated in the errors and warning messages, "The program cannot perform supercritical flow through multiple culverts."

The realigned Whites Creek Branch 2 including drop structures and box culverts under Wedge Parkway are in substantial compliance with CLOMR Case Number **05-09-0503R**. The effective FIRM is shown in Figure 7 and the proposed annotated FIRM is shown in Figure 8.

Figure 4. Looking northeast (downstream) at the box culverts under Arrow Creek Parkway. The approach is steep because these culverts also cross under Steamboat Ditch (flowing from left to right past the chain link fence, see Figure 6).




Figure 5. Looking upstream out of the center culvert shown above.



Figure 6. Looking north at the Steamboat Ditch. The road in the background is Arrow Creek Parkway, and the culverts shown in Figures 4 and 5 above flow from right to left under this.



Figure 7. Existing FIRM

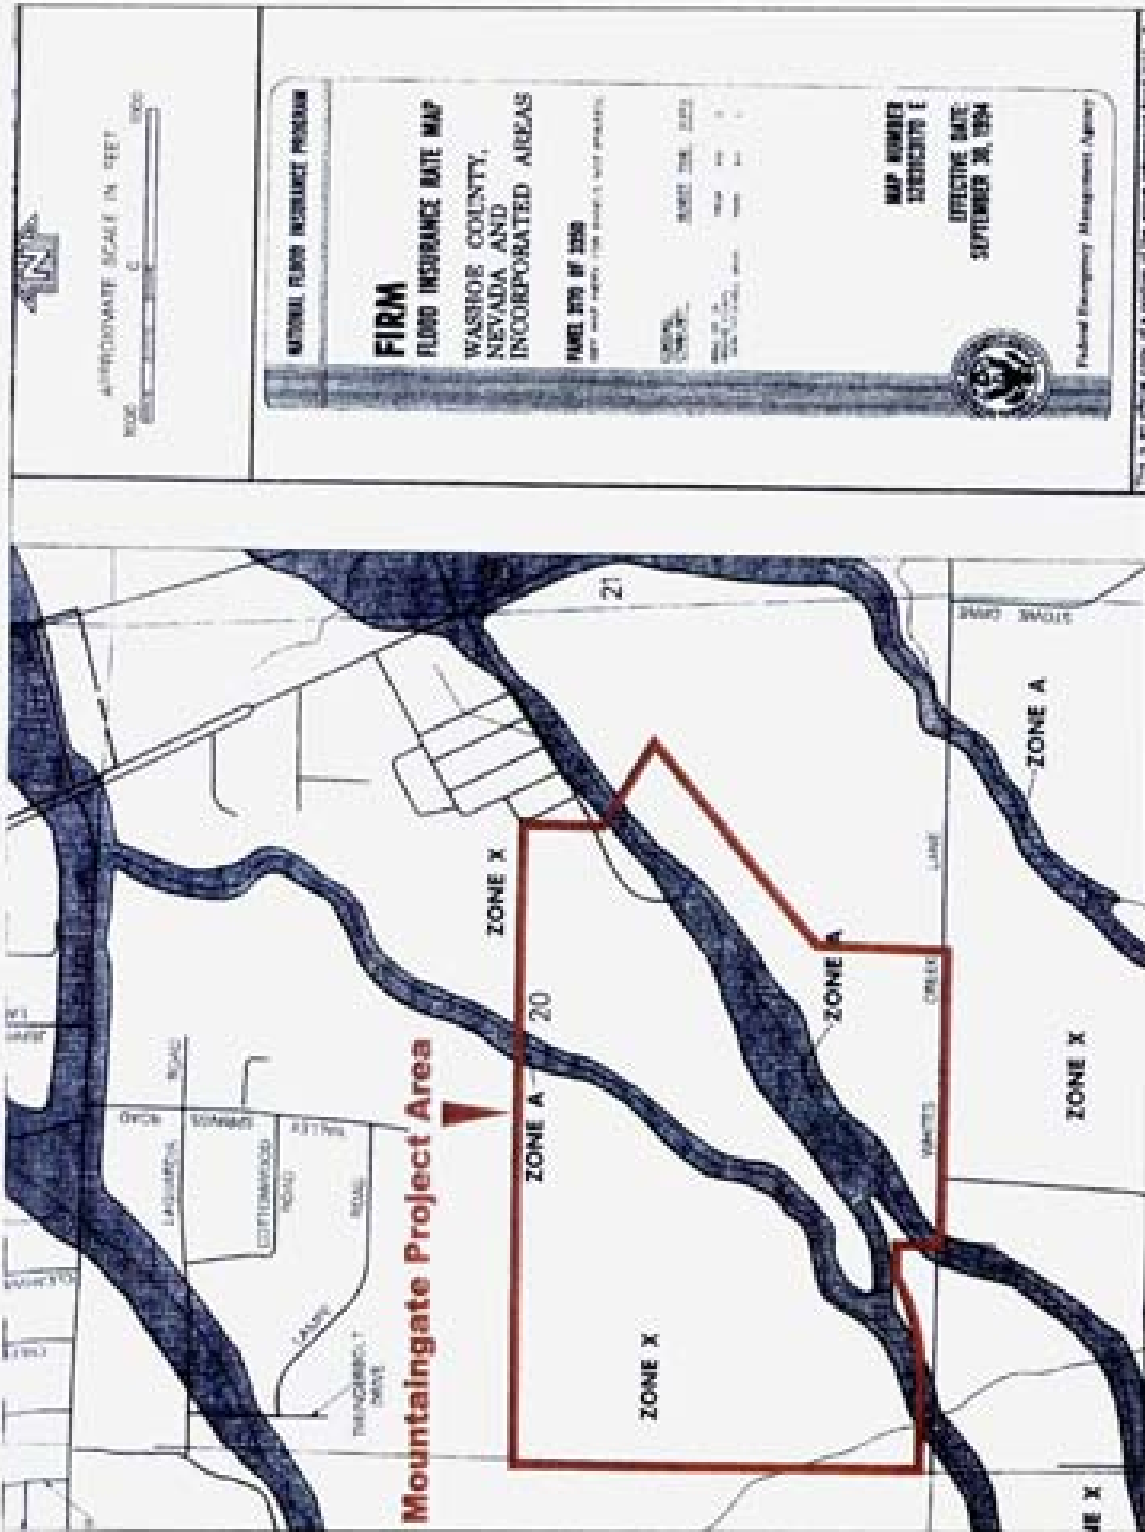

6.0 FINDINGS

The findings of this study are listed below:

1. A channel has been designed that can contain and convey the 100-year flow in Whites Creek Branch 2 (1144 cfs) with more than one foot of freeboard.
2. Flow velocities have been maintained at acceptable levels through the use of geotextile matting and gabion drop structures. During the 100-year event, flow will leave the Mountaingate property at under five feet per second.
3. Construction of this channel has re-routed Branch 2 of Whites Creek, changing the effective FIRM in the project area as shown previously in Figure 8.

7.0 REFERENCES

City of Reno, Public Works Department, Design Manual, November, 2000.

City of Reno, Major Drainageways Plan, June, 1992.

Department of Water Resources, Washoe County, Nevada, Southern Washoe County, Precipitation Frequency of the United States, NOAA Atlas 14, Volume 1 - Semi-arid Southwestern United States (Map), April 1997.

Nimbus Engineers, Whites Creek Detention Facility Feasibility Study, Washoe County, Nevada, June 1993.

Nimbus Engineers, Hydrologic and Hydraulic Analysis Wedge Meadows Subdivision, Washoe County, Nevada, November 1995.

Nimbus Engineers, Hydrologic and Hydraulic Analysis, Double Diamond Ranch, Phase I, Application for Letter of Map Revision, Additional Data Submittal, August 1996.

Nimbus Engineers, Request for Letter of Map Revision (LOMR) Galena Meadows Subdivision, February 2001.

Nimbus Engineers, Application for Letter of Map Revision (LOMR), Branch 3 Whites Creek

Nimbus Engineers, Application for Conditional Letter of Map Revision (CLOMR), Branch 2 Whites Creek, January 2005.

Washoe County, Hydrologic Criteria and Drainage Design Manual, December 2, 1996.

U.S. Army Corps of Engineers, Hydrologic Engineering Center, Computer Program 723-X6-L2010, HEC-1, Flood Hydrograph Package, version 4.1, June 1998.

U.S. Army Corps of Engineers, Hydrologic Engineering Center, HEC-RAS: River Analysis System, version 3.0, Mar 2001.

U.S. Department of Agriculture, Soil Conservation Service, Soil Survey of Washoe County, Nevada, South Part, August 1983.

U.S. Department of Agriculture, Natural Resource Conservation Service, Urban Hydrology for Small Watersheds (TR-55), June 1986.

Aerial photograph (2004) in Figure 1 from <http://maps.cityofreno.net/>


APPENDIX A

APPENDIX A
FEMA FORMS

MT-2

MITIGATION DIVISION
HAZARD IDENTIFICATION BRANCH
REVISIONS TO NATIONAL FLOOD INSURANCE PROGRAM MAPS

APPLICATION FORMS AND INSTRUCTIONS FOR CONDITIONAL
LETTERS OF MAP REVISION AND LETTERS OF MAP REVISION

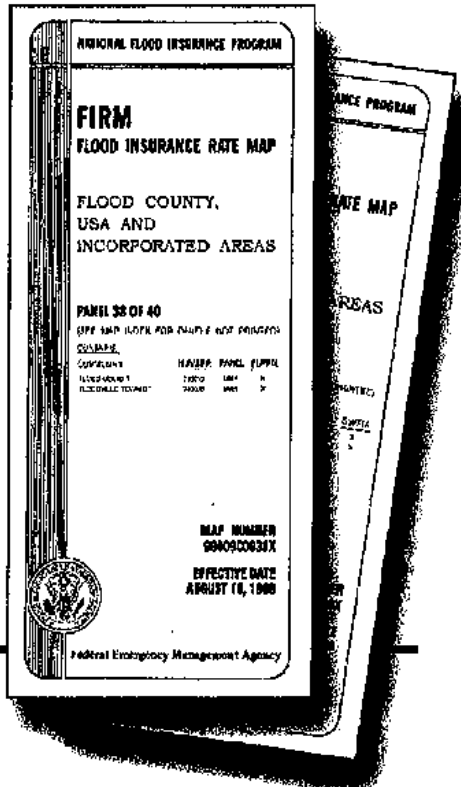

MT-2
FEMA FORM 81-89 SERIES
SEPT 04



FEMA

PAPERWORK BURDEN DISCLOSURE NOTICE

Public reporting burden for this form is estimated to average 1 hour per response. The burden estimate includes the time for reviewing instructions, searching existing data sources, gathering and maintaining the needed data, and completing, reviewing, and submitting the form. You are not required to respond to this collection of information unless a valid OMB control number appears in the upper right corner of this form. Send comments regarding the accuracy of the burden estimate and any suggestions for reducing this burden to: Information Collections Management, U.S. Department of Homeland Security, Federal Emergency Management Agency, 500 C Street, SW, Washington DC 20472, Paperwork Reduction Project (1660-0016). Submission of the form is required to obtain or retain benefits under the National Flood Insurance Program. **Please do not send your completed survey to the above address.**

A. REQUESTED RESPONSE FROM DHS-FEMA

This request is for a (check one):

- CLOMR: A letter from DHS-FEMA commenting on whether a proposed project, if built as proposed, would justify a map revision, or proposed hydrology changes (See 44 CFR Ch. 1, Parts 60, 65 & 72).
- LOMR: A letter from DHS-FEMA officially revising the current NFIP map to show the changes to floodplains, regulatory floodway or flood elevations. (See Parts 60 & 65 of the NFIP Regulations.)

B. OVERVIEW

1. The NFIP map panel(s) affected for all impacted communities is (are):

Community No.	Community Name	State	Map No.	Panel No.	Effective Date
Ex: 480301	City of Katy	TX	480301	0005D	02/09/83
480287	Harris County	TX	48201C	0220G	09/28/90
3320020	City of Reno	NV	32031C	3170E	SEPT. 30,1994

2. Flooding Source: WHITES CREEK BRANCH 2

3. Project Name/Identifier: MOUNTAINGATE LOMR

4. FEMA zone designations affected: A, X (choices: A, AH, AO, A1-A30, A99, AE, AR, V, V1-V30, VE, B, C, D, X)

5. Basis for Request and Type of Revision:

a. The basis for this revision request is (check all that apply)

- Physical Change
- Improved Methodology/Data
- Regulatory Floodway Revision
- Other (Attach Description)

Note: A photograph and narrative description of the area of concern is not required, but is very helpful during review.

b. The area of revision encompasses the following types of flooding and structures (check all that apply)

- Types of Flooding:
- Riverine
 - Coastal
 - Shallow Flooding (e.g., Zones AO and AH)
 - Alluvial fan
 - Lakes
 - Other (Attach Description)
- Structures:
- Channelization
 - Levee/Floodwall
 - Bridge/Culvert
 - Dam
 - Fill
 - Other, Attach Description DROP STRUCTURES

C. REVIEW FEE

Has the review fee for the appropriate request category been included?

Yes

Fee amount: \$4000

No, Attach Explanation

Please see the DHS-FEMA Web site at http://www.fema.gov/fhm/fm_fees.shtm for Fee Amounts and Exemptions.

D. SIGNATURE

All documents submitted in support of this request are correct to the best of my knowledge. I understand that any false statement may be punishable by fine or imprisonment under Title 18 of the United States Code, Section 1001.

Name: David Westhoff

Company: Quad Knopf

Mailing Address:
9600 Prototype Court
Reno, NV 89521

Daytime Telephone No.:
775-324-1212

Fax No.:
775-324-2311

E-Mail Address: davidw@quadknopf.com

Signature of Requester (required):

David Westhoff

Date:

June 19, 2006

As the community official responsible for floodplain management, I hereby acknowledge that we have received and reviewed this Letter of Map Revision (LOMR) or conditional LOMR request. Based upon the community's review, we find the completed or proposed project meets or is designed to meet all of the community floodplain management requirements, including the requirement that no fill be placed in the regulatory floodway, and that all necessary Federal, State, and local permits have been, or in the case of a conditional LOMR, will be obtained. In addition, we have determined that the land and any existing or proposed structures to be removed from the SFHA are or will be reasonably safe from flooding as defined in 44CFR 65.2(c), and that we have available upon request by FEMA, all analyses and documentation used to make this determination.

Community Official's Name and Title: Steve Varela, Director of Public Works, City of Reno

Telephone No.:
775-334-2350

Community Name: City of Reno

Community Official's Signature (required):

Date:

CERTIFICATION BY REGISTERED PROFESSIONAL ENGINEER AND/OR LAND SURVEYOR

This certification is to be signed and sealed by a licensed land surveyor, registered professional engineer, or architect authorized by law to certify elevation information. All documents submitted in support of this request are correct to the best of my knowledge. I understand that any false statement may be punishable by fine or imprisonment under Title 18 of the United States Code, Section 1001.

Certifier's Name:

Jette Brooke

License No.:

8658

Expiration Date:

12/31/06

Company Name:

PLACES, CSI.

Telephone No.:

775-355 7721

Fax No.:

775-355-7795

Signature:

Jette Brooke

Date:

06/20/06

Ensure the forms that are appropriate to your revision request are included in your submittal.

Form Name and (Number)

Required if...

- Riverine Hydrology and Hydraulics Form (Form 2) New or revised discharges or water-surface elevations
- Riverine Structures Form (Form 3) Channel is modified, addition/revision of bridge/culverts, addition/revision of levees/floodwall, addition/revision of dam
- Coastal Analysis Form (Form 4) New or revised coastal elevations
- Coastal Structures Form (Form 5) Addition/revision of coastal structure
- Alluvial Fan Flooding Form (Form 6) Flood control measures on alluvial fans

Seal (Optional)

PAPERWORK REDUCTION ACT

Public reporting burden for this form is estimated to average 3.25 hours per response. The burden estimate includes the time for reviewing instructions, searching existing data sources, gathering and maintaining the needed data, and completing, reviewing, and submitting the form. You are not required to respond to this collection of information unless a valid OMB control number appears in the upper right corner of this form. Send comments regarding the accuracy of the burden estimate and any suggestions for reducing this burden to: Information Collections Management, U.S. Department of Homeland Security, Federal Emergency Management Agency, 500 C Street, SW, Washington DC 20472, Paperwork Reduction Project (1660-0016). Submission of the form is required to obtain or retain benefits under the National Flood Insurance Program. Please do not send your completed survey to the above address.

Flooding Source: Whites Creek Branch 2
 Note: Fill out one form for each flooding source studied

A. HYDROLOGY

1. Reason for New Hydrologic Analysis (check all that apply)

- Not revised (skip to section 2) No existing analysis Improved data
 Alternative methodology Proposed Conditions (CLOMR) Changed physical condition of watershed

2. Comparison of Representative 1%-Annual-Chance Discharges

Location	Drainage Area (Sq. Mi.)	FIS (cfs)	Revised (cfs)
----------	-------------------------	-----------	---------------

3. Methodology for New Hydrologic Analysis (check all that apply)

- Statistical Analysis of Gage Records Precipitation/Runoff Model [TR-20, HEC-1, HEC-HMS etc.]
 Regional Regression Equations Other (please attach description)

Please enclose all relevant models in digital format, maps, computations (including computation of parameters) and documentation to support the new analysis. The document, "Numerical Models Accepted by FEMA for NFIP Usage" lists the models accepted by DHS-FEMA. This document can be found at: http://www.fema.gov/fhm/en_modl.shtm.

4. Review/Approval of Analysis

If your community requires a regional, state, or federal agency to review the hydrologic analysis, please attach evidence of approval/review.

5. Impacts of Sediment Transport on Hydrology

Was sediment transport considered? Yes No If yes, then fill out Section F (Sediment Transport) of Form 3. If No, then attach your explanation for why sediment transport was not considered.

B. HYDRAULICS

1. Reach to be Revised

	Description	Cross Section	Water-Surface Elevations (ft.)	
			Effective	Proposed/Revised
Downstream Limit	Branch 2 Whites Crk. North of Mountaingate Property Line	1700	N/A	4569.01
Upstream Limit	Branch 2 Whites Crk. at Arrowcreek RCBs	8800	N/A	4775.94

2. Hydraulic Method Used

Hydraulic Analysis HEC-RAS [HEC-2, HEC-RAS, Other (Attach description)]

B. HYDRAULICS (CONTINUED)

3. Pre-Submittal Review of Hydraulic Models

DHS-FEMA has developed two review programs, CHECK-2 and CHECK-RAS, to aid in the review of HEC-2 and HEC-RAS hydraulic models, respectively. These review programs verify that the hydraulic estimates and assumptions in the model data are in accordance with NFIP requirements, and that the data are comparable with the assumptions and limitations of HEC-2/HEC-RAS. CHECK-2 and CHECK-RAS identify areas of potential error or concern. These tools do not replace engineering judgment. CHECK-2 and CHECK-RAS can be downloaded from http://www.fema.gov/fhm/fm_soft.shtm. We recommend that you review your HEC-2 and HEC-RAS models with CHECK-2 and CHECK-RAS. If you disagree with a message, please attach an explanation of why the message is not valid in this case. Review of your submittal and resolution of valid modeling discrepancies will result in reduced review time.

HEC-2/HEC-RAS models reviewed with CHECK-2/CHECK-RAS? Yes No

4. **Models Submitted** Diskette Submitted **Natural Run** **Floodway Run** **Datum**

Duplicate Effective Model*	File Name:	Plan Name:	File Name:	Plan Name:	_____
Corrected Effective Model*	File Name:	Plan Name:	File Name:	Plan Name:	_____
Existing or Pre-Project Conditions Model	File Name:	Plan Name:	File Name:	Plan Name:	_____
Revised or Post-Project Conditions Model	File Name:	Plan Name:	File Name:	Plan Name:	1929
Other - (attach description)	File Name:	Plan Name:	File Name:	Plan Name:	_____

060212_MOUNTAINCATE_LOMR_PPJ MOUNTAINCATE LOMR

*Not required for revisions to approximate 1%-annual-chance floodplains (Zone A) - for details, refer to the corresponding section of the instructions.

The document "Numerical Models Accepted by FEMA for NFIP Usage" lists the models accepted by DHS-FEMA. This document can be found at: http://www.fema.gov/fhm/en_modl.shtm.

C. MAPPING REQUIREMENTS

A certified topographic map must be submitted showing the following information (where applicable): the boundaries of the effective, existing, and proposed conditions 1%-annual-chance floodplain (for approximate Zone A revisions) or the boundaries of the 1%- and 0.2%-annual-chance floodplains and regulatory floodway (for detailed Zone AE, AO, and AH revisions); location and alignment of all cross sections with stationing control indicated; stream, road, and other alignments (e.g., dams, levees, etc.); current community easements and boundaries; boundaries of the requester's property; certification of a registered professional engineer registered in the subject State; location and description of reference marks; and the referenced vertical datum (NGVD, NAVD, etc.).

Note that the boundaries of the existing or proposed conditions floodplains and regulatory floodway to be shown on the revised FIRM and/or FBFM must tie-in with the effective floodplain and regulatory floodway boundaries. Please attach a copy of the effective FIRM and/or FBFM, annotated to show the boundaries of the revised 1%- and 0.2%-annual-chance floodplains and regulatory floodway that tie-in with the boundaries of the effective 1%- and 0.2%-annual-chance floodplain and regulatory floodway at the upstream and downstream limits of the area of revision.

Annotated FIRM and/or FBFM Included Digital Mapping (GIS/CADD) Data Submitted (Recommended)

D. COMMON REGULATORY REQUIREMENTS*

1. For CLOMR requests, do Base Flood Elevations (BFEs) increase? Yes No

For CLOMR requests, if either of the following is true, please submit evidence of compliance with Section 65.12 of the NFIP regulations:

- The proposed project encroaches upon a regulatory floodway and would result in increases above 0.00 foot.
- The proposed project encroaches upon a SFHA with or without BFEs established and would result in increases above 1.00 foot.

2. Does the request involve the placement or proposed placement of fill? Yes No

If Yes, the community must be able to certify that the area to be removed from the special flood hazard area, to include any structures or proposed structures, meets all of the standards of the local floodplain ordinances, and is reasonably safe from flooding in accordance with the NFIP regulations set forth at 44 CFR 60.3(a)(3), 65.5(a)(4), and 65.6(a)(14). Please see the MT-2 instructions for more information.

3. For LOMR/CLOMR requests, is the regulatory floodway being revised? Yes No

If Yes, attach evidence of regulatory floodway revision notification. As per Paragraph 65.7(b)(1) of the NFIP Regulations, notification is required for requests involving revisions to the regulatory floodway. (Not required for revisions to approximate 1%-annual-chance floodplains [studied Zone A designation] unless a regulatory floodway is being added. Elements and examples of regulatory floodway revision notification can be found in the MT-2 Form 2 Instructions.)

4. For LOMR/CLOMR requests, does this request have the potential to impact an endangered species? Yes No

If Yes, please submit documentation from the community to show that they have complied with Sections 9 and 10 of the Endangered Species Act (ESA). Section 9 of the ESA prohibits anyone from "taking" or harming an endangered species. If an action might harm an endangered species, a permit is required from U.S. Fish and Wildlife Service or National Marine Fisheries Service under Section 10 of the ESA.

For actions authorized, funded, or being carried out by Federal or State agencies, please submit documentation from the agency showing its compliance with Section 7(a)(2) of the ESA.

5. For LOMR requests, does this request require property owner notification and acceptance of BFE increases? Yes No

If Yes, please attach proof of property owner notification and acceptance (if available). Elements of and examples of property owner notification can be found in the MT-2 Form 2 Instructions.

* Not inclusive of all applicable regulatory requirements. For details, see 44 CFR parts 60 and 65.

PAPERWORK REDUCTION ACT

Public reporting burden for this form is estimated to average 7 hours per response. The burden estimate includes the time for reviewing instructions, searching existing data sources, gathering and maintaining the needed data, and completing, reviewing, and submitting the form. You are not required to respond to this collection of information unless a valid OMB control number appears in the upper right corner of this form. Send comments regarding the accuracy of the burden estimate and any suggestions for reducing this burden to: Information Collections Management, U.S. Department of Homeland Security, Federal Emergency Management Agency, 500 C Street, SW, Washington DC 20472, Paperwork Reduction Project (1660-0016). Submission of the form is required to obtain or retain benefits under the National Flood Insurance Program. **Please do not send your completed survey to the above address.**

Flooding Source: Whites Creek Branch 2
Note: Fill out one form for each flooding source studied

A. GENERAL

Complete the appropriate section(s) for each Structure listed below:

- Channelization..... complete Section B
- Bridge/Culvert..... complete Section C
- Dam..... complete Section D
- Levee/Floodwall..... complete Section E
- Sediment Transport complete Section F (if required)

Description Of Structure

1. **Name of Structure: Whites Creek Branch 2 Channel**
Type (check one): Channelization Bridge/Culvert Levee/Floodwall Dam
Location of Structure: Channel alongside and west of ArrowCreek Parkway
Downstream Limit/Cross Section: 1000
Upstream Limit/Cross Section: 8800
2. **Name of Structure: Arrow Springs Drive Culverts**
Type (check one): Channelization Bridge/Culvert Levee/Floodwall Dam
Location of Structure: Arrow Springs Drive crossing Whites Creek Branch 2 channel
Downstream Limit/Cross Section: 8100
Upstream Limit/Cross Section: 8200
3. **Name of Structure: Wedge Parkway Culverts**
Type (check one) Channelization Bridge/Culvert Levee/Floodwall Dam
Location of Structure: Wedge Parkway crossing Whites Creek Branch 2 channel
Downstream Limit/Cross Section: 3800
Upstream Limit/Cross Section: 3900

NOTE: For more structures, attach additional pages as needed.

B. CHANNELIZATION

Flooding Source: Whites Creek Branch 2

Name of Structure: realigned Whites Creek Branch 2 channel

1. Accessory Structures

The channelization includes (check one):

- | | |
|--|--|
| <input type="checkbox"/> Levees (Attach Section E (Levee/Floodwall)) | <input checked="" type="checkbox"/> Drop structures |
| <input type="checkbox"/> Superelevated sections | <input type="checkbox"/> Transitions in cross sectional geometry |
| <input type="checkbox"/> Debris basin/detention basin | <input type="checkbox"/> Energy dissipator |
| <input type="checkbox"/> Other (Describe): | |

2. Drawing Checklist

Attach the plans of the channelization certified by a registered professional engineer, as described in the instructions.

3. Hydraulic Considerations

The channel was designed to carry 1144 (cfs) and/or the 100-year flood.

The design elevation in the channel is based on (check one):

- Subcritical flow Critical flow Supercritical flow Energy grade line

If there is the potential for a hydraulic jump at the following locations, check all that apply and attach an explanation of how the hydraulic jump is controlled without affecting the stability of the channel.

- Inlet to channel Outlet of channel At Drop Structures At Transitions
 Other locations (specify):

Hydraulic jumps occur over the gabion drop structures. Channel stability is provided by geotextile lining and grouted rip-rap (see as-built details, Appendix C). Adequate freeboard is maintained throughout the channel.

4. Sediment Transport Considerations

Was sediment transport considered? Yes No If Yes, then fill out Section F (Sediment Transport).

If No, then attach your explanation for why sediment transport was not considered.

C. BRIDGE/CULVERT

Flooding Source: Whites Creek Branch 2

Name of Structure: Arrow Springs Drive Culverts

1. This revision reflects (check one):

- New bridge/culvert not modeled in the FIS
 Modified bridge/culvert previously modeled in the FIS
 New analysis of bridge/culvert previously modeled in the FIS

2. Hydraulic model used to analyze the structure (e.g., HEC-2 with special bridge routine, WSPRO, HY8); HEC-RAS
If different than hydraulic analysis for the flooding source, justify why the hydraulic analysis used for the flooding source could not analyze the structures. Attach justification.

3. Attach plans of the structures certified by a registered professional engineer. The plan detail and information should include the following (check the information that has been provided):

- | | |
|--|--|
| <input checked="" type="checkbox"/> Dimensions (height, width, span, radius, length) | <input checked="" type="checkbox"/> Erosion Protection – Geotextile Liner |
| <input checked="" type="checkbox"/> Shape (culverts only) | <input type="checkbox"/> Low Chord Elevations – Upstream and Downstream |
| <input checked="" type="checkbox"/> Material | <input type="checkbox"/> Top of Road Elevations – Upstream and Downstream |
| <input type="checkbox"/> Beveling or Rounding | <input type="checkbox"/> Structure Invert Elevations – Upstream and Downstream |
| <input checked="" type="checkbox"/> Wing Wall Angle | <input type="checkbox"/> Stream Invert Elevations – Upstream and Downstream |
| <input type="checkbox"/> Skew Angle | <input type="checkbox"/> Cross-Section Locations |
| <input type="checkbox"/> Distances Between Cross Sections | |

4. Sediment Transport Considerations

Was sediment transport considered? Yes No If yes, then fill out Section F (Sediment Transport).

If No, then attach your explanation for why sediment transport was not considered.

C. BRIDGE/CULVERT - Continued

Flooding Source: **Whites Creek Branch 2**

Name of Structure: **Wedge Parkway Culverts**

3. This revision reflects (check one):

- New bridge/culvert not modeled in the FIS
- Modified bridge/culvert previously modeled in the FIS
- New analysis of bridge/culvert previously modeled in the FIS

4. Hydraulic model used to analyze the structure (e.g., HEC-2 with special bridge routine, WSPRO, HY8); HEC-RAS
If different than hydraulic analysis for the flooding source, justify why the hydraulic analysis used for the flooding source could not analyze the structures. Attach justification.

3. Attach plans of the structures certified by a registered professional engineer. The plan detail and information should include the following (check the information that has been provided):

- | | |
|--|--|
| <input checked="" type="checkbox"/> Dimensions (height, width, span, radius, length) | <input type="checkbox"/> Erosion Protection |
| <input checked="" type="checkbox"/> Shape (culverts only) | <input type="checkbox"/> Low Chord Elevations -- Upstream and Downstream |
| <input checked="" type="checkbox"/> Material | <input type="checkbox"/> Top of Road Elevations -- Upstream and Downstream |
| <input type="checkbox"/> Beveling or Rounding | <input checked="" type="checkbox"/> Structure Invert Elevations -- Upstream and Downstream |
| <input checked="" type="checkbox"/> Wing Wall Angle | <input type="checkbox"/> Stream Invert Elevations -- Upstream and Downstream |
| <input type="checkbox"/> Skew Angle | <input type="checkbox"/> Cross-Section Locations |
| <input type="checkbox"/> Distances Between Cross Sections | |

4. Sediment Transport Considerations


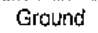
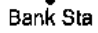

Was sediment transport considered? Yes No If yes, then fill out Section F (Sediment Transport).
If No, then attach your explanation for why sediment transport was not considered.


APPENDIX B

APPENDIX B

HEC-RAS OUTPUT

060212 -Mountaingate LOMR

Legend	
	WS PF 1
	Ground
	Bank Sta
	Ground





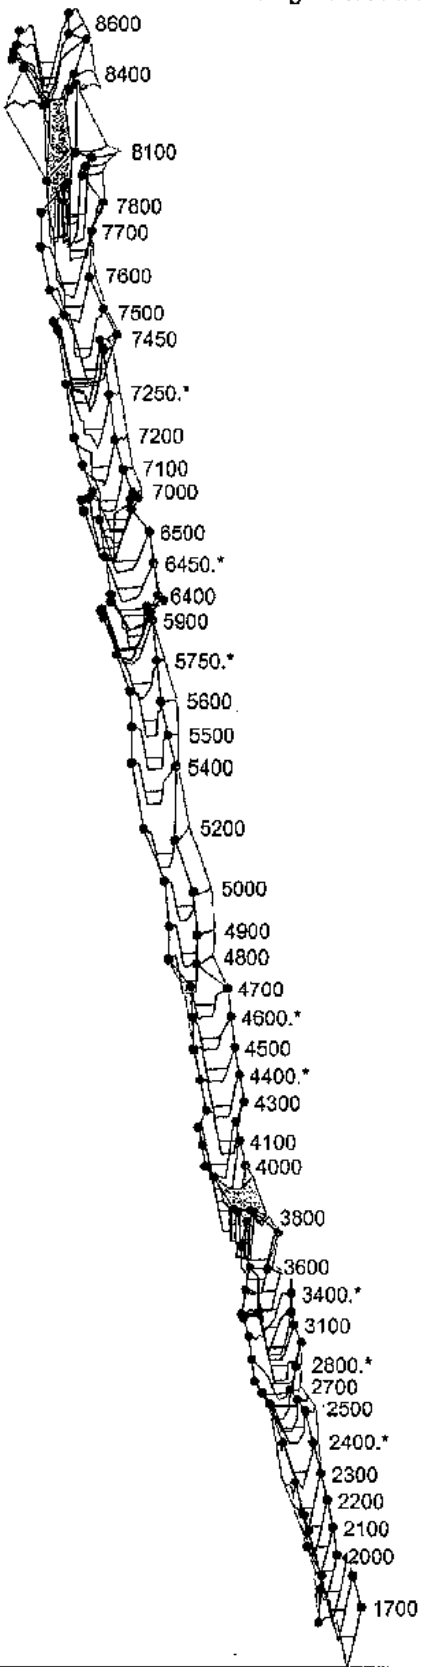







HEC-RAS Plan: LOMR River: RIVER-1 Reach: Reach-1 Profile: PF 1


Reach	River Sta	Profile	Q Total (cfs)	Min Ch E (ft)	W.S. Elev (ft)	Crit W.S. (ft)	E.G. Elev (ft)	E.G. Slope (ft/ft)	Vel Chnl (ft/s)	Flow Area (sq ft)	Top Width (ft)	Froude # Chl
Reach-1	8700	PF 1	1144.00	4771.05	4775.94	4775.94	4777.39	0.022075	9.65	118.49	41.51	1.01
Reach-1	8800	PF 1	1144.00	4770.14	4773.80	4774.38	4776.15	0.059495	12.82	89.23	43.46	1.58
Reach-1	8900	PF 1	1144.00	4769.10	4773.03	4773.24	4774.44	0.030688	9.54	119.92	55.27	1.14
Reach-1	8400	PF 1	1144.00	4767.22	4770.90	4771.57	4773.14	0.045350	11.99	95.40	41.84	1.40
Reach-1	8300	PF 1	1144.00	4763.94	4767.72	4768.75	4771.01	0.087704	14.55	78.64	42.61	1.89
Reach-1	8200	PF 1	1144.00	4756.57	4758.70	4760.58	4766.25	0.218856	22.05	51.89	28.08	2.86
Reach-1	8150	Culvert										
Reach-1	8100	PF 1	1144.00	4747.80	4753.98	4753.98	4754.28	0.002556	4.44	257.88	54.08	2.86
Reach-1	8000	PF 1	1144.00	4748.43	4753.70	4753.70	4754.23	0.006242	5.85	195.50	46.21	0.50
Reach-1	7900	PF 1	1144.00	4748.25	4752.59	4752.59	4754.07	0.023407	9.75	117.29	39.92	1.00
Reach-1	7800	PF 1	1144.00	4746.10	4748.00	4749.17	4752.38	0.194251	16.80	68.10	51.65	2.58
Reach-1	7700	PF 1	1144.00	4740.18	4742.98	4743.72	4745.33	0.066197	12.32	92.82	52.63	1.64
Reach-1	7600	PF 1	1144.00	4737.32	4740.18	4740.22	4741.45	0.024458	9.06	126.28	52.11	1.03
Reach-1	7500	PF 1	1144.00	4731.66	4733.40	4734.56	4737.58	0.151878	16.39	69.80	47.38	2.38
Reach-1	7450	PF 1	1144.00	4728.27	4730.66	4730.94	4732.07	0.035822	9.54	119.96	62.85	1.22
Reach-1	7400	PF 1	1144.00	4724.15	4729.11	4727.22	4729.41	0.003392	4.44	237.86	72.22	0.41
Reach-1	7350	PF 1	1144.00	4723.42	4728.67	4728.67	4729.27	0.010983	6.20	184.53	75.74	0.70
Reach-1	7300	PF 1	1144.00	4723.27	4728.18	4728.18	4729.17	0.024553	7.98	143.29	73.89	1.01
Reach-1	7250*	PF 1	1144.00	4718.50	4722.06	4722.77	4724.44	0.071709	12.39	92.34	54.42	1.68
Reach-1	7200	PF 1	1144.00	4713.64	4717.08	4717.33	4718.62	0.033630	9.97	114.72	51.39	1.18
Reach-1	7100	PF 1	1144.00	4710.12	4712.12	4712.94	4714.83	0.080080	13.22	86.50	49.87	1.77
Reach-1	7000	PF 1	1144.00	4707.24	4709.56	4709.93	4711.09	0.042028	9.94	115.14	63.79	1.30
Reach-1	6900	PF 1	1144.00	4705.52	4708.04	4708.53	4710.02	0.064102	11.28	101.45	63.39	1.57
Reach-1	6800	PF 1	1144.00	4702.60	4704.50	4705.82	4709.26	0.161479	17.51	65.34	41.44	2.46
Reach-1	6700	PF 1	1144.00	4702.47	4705.09	4705.53	4706.76	0.046599	10.39	110.13	61.32	1.37
Reach-1	6600	PF 1	1144.00	4702.43	4705.20	4705.47	4706.58	0.035394	9.41	121.55	64.71	1.21
Reach-1	6500	PF 1	1144.00	4701.10	4703.26	4703.70	4704.85	0.052538	10.14	112.86	72.53	1.43
Reach-1	6450*	PF 1	1144.00	4697.30	4699.94	4700.08	4701.05	0.030042	8.45	135.37	75.10	1.11
Reach-1	6400	PF 1	1144.00	4693.53	4697.57	4696.45	4697.92	0.005977	4.74	241.14	94.67	0.52
Reach-1	6300	PF 1	1144.00	4694.10	4696.72	4696.72	4697.63	0.024809	7.67	149.10	82.90	1.01
Reach-1	6200	PF 1	1144.00	4690.58	4692.96	4694.13	4697.16	0.145452	16.44	69.57	46.02	2.36
Reach-1	6100	PF 1	1144.00	4688.90	4691.06	4692.07	4694.33	0.102887	14.51	78.86	48.33	2.00
Reach-1	5000	PF 1	1144.00	4688.80	4690.84	4691.74	4693.81	0.110624	13.83	82.73	58.29	2.05
Reach-1	5900	PF 1	1144.00	4688.29	4691.32	4691.34	4692.36	0.024053	8.21	139.40	68.24	1.01
Reach-1	5750*	PF 1	1144.00	4683.70	4686.83	4687.24	4688.49	0.043733	10.36	110.43	59.56	1.34
Reach-1	5600	PF 1	1144.00	4679.10	4682.11	4682.44	4683.94	0.033050	10.86	105.34	40.86	1.19
Reach-1	5500	PF 1	1144.00	4674.70	4676.79	4677.51	4679.23	0.065140	12.55	91.16	49.03	1.62
Reach-1	5400	PF 1	1144.00	4670.00	4672.43	4672.80	4674.11	0.038069	10.42	109.78	52.51	1.27
Reach-1	5200	PF 1	1144.00	4661.70	4664.21	4664.71	4666.14	0.045119	11.17	102.42	50.25	1.36






HEC-RAS Plan: LOMR River: RIVER-1 Reach: Reach-1 Profile: PF 1 (Continued)


Reach	River Sta	Profile	Q Total (cfs)	Min Ch El (ft)	W.S. Elev (ft)	Crit W.S. (ft)	E.G. Elev (ft)	E.G. Slope (ft/ft)	Vel Chnl (ft/s)	Flow Area (sq ft)	Top Width (ft)	Froude # Chl
Reach-1	5000	PF 1	1144.00	4654.54	4657.32	4657.67	4659.01	0.037005	10.44	109.61	50.86	1.25
Reach-1	4900	PF 1	1144.00	4648.62	4650.98	4651.55	4653.10	0.049528	11.67	98.07	46.94	1.42
Reach-1	4800	PF 1	1144.00	4644.83	4647.32	4647.73	4649.15	0.039101	10.87	105.27	46.69	1.28
Reach-1	4700	PF 1	1144.00	4641.59	4644.33	4644.44	4645.58	0.027250	8.97	127.58	59.59	1.08
Reach-1	4600*	PF 1	1144.00	4637.40	4639.61	4640.26	4641.71	0.059612	11.63	98.37	56.19	1.55
Reach-1	4500	PF 1	1144.00	4633.20	4635.62	4635.91	4637.03	0.036378	9.55	119.85	63.73	1.23
Reach-1	4400*	PF 1	1144.00	4628.20	4630.40	4631.00	4632.47	0.057149	11.56	98.96	55.30	1.52
Reach-1	4300	PF 1	1144.00	4623.20	4625.60	4626.07	4627.45	0.043242	10.91	104.85	51.50	1.35
Reach-1	4200	PF 1	1144.00	4620.13	4622.64	4623.03	4624.35	0.038488	10.50	108.94	51.91	1.28
Reach-1	4100	PF 1	1144.00	4616.97	4619.50	4619.96	4621.32	0.042106	10.84	105.56	51.31	1.33
Reach-1	4000	PF 1	1144.00	4612.90	4615.15	4615.93	4617.66	0.006473	5.78	197.94	60.25	0.56
Reach-1	3900	PF 1	1144.00	4611.96	4617.05	4614.78	4617.45	0.003567	5.10	224.48	45.66	0.41
Reach-1	3850	Culvert										
Reach-1	3800	PF 1	1144.00	4611.14	4614.74	4614.74	4616.31	0.022452	10.05	113.85	36.67	1.00
Reach-1	3700	PF 1	1144.00	4610.08	4611.72	4612.54	4614.48	0.102142	13.32	85.86	59.30	1.95
Reach-1	3600	PF 1	1144.00	4607.12	4609.81	4609.81	4611.02	0.023526	8.82	128.74	54.15	1.00
Reach-1	3500	PF 1	1144.00	4605.04	4608.67	4607.95	4608.46	0.010981	7.11	160.85	51.31	0.71
Reach-1	3400*	PF 1	1144.00	4602.30	4606.81	4606.81	4608.17	0.023071	9.37	122.13	45.61	1.01
Reach-1	3300	PF 1	1144.00	4599.61	4604.75	4604.89	4606.22	0.025432	9.72	117.73	45.78	1.07
Reach-1	3200	PF 1	1144.00	4599.51	4601.12	4602.35	4605.74	0.187987	17.24	66.36	49.86	2.63
Reach-1	3100	PF 1	1144.00	4599.00	4601.24	4601.80	4603.20	0.054218	11.25	101.65	56.39	1.48
Reach-1	3000	PF 1	1144.00	4598.90	4601.31	4601.68	4602.91	0.040546	10.17	112.53	58.38	1.29
Reach-1	2900	PF 1	1144.00	4596.40	4599.33	4599.33	4600.62	0.023432	9.12	125.46	49.03	1.00
Reach-1	2800*	PF 1	1144.00	4594.00	4597.36	4597.50	4598.56	0.029729	8.80	130.07	66.18	1.11
Reach-1	2700	PF 1	1144.00	4591.55	4596.61	4594.39	4596.84	0.002470	3.84	297.75	80.19	0.35
Reach-1	2600*	PF 1	1144.00	4591.50	4596.17	4594.40	4596.47	0.003511	4.34	263.42	77.07	0.41
Reach-1	2500	PF 1	1144.00	4591.55	4594.40	4594.40	4595.47	0.023795	8.33	137.34	64.72	1.01
Reach-1	2400*	PF 1	1144.00	4584.20	4587.28	4588.56	4591.50	0.121327	16.48	69.40	39.87	2.20
Reach-1	2300	PF 1	1144.00	4576.86	4581.80	4582.73	4584.78	0.055931	13.87	82.49	33.42	1.56
Reach-1	2200	PF 1	1144.00	4574.70	4580.38	4580.30	4581.75	0.020217	9.38	121.98	41.67	0.97
Reach-1	2100	PF 1	1144.00	4572.65	4578.22	4578.22	4579.63	0.022159	9.52	120.14	43.14	1.01
Reach-1	2000	PF 1	1144.00	4570.09	4575.44	4575.68	4577.13	0.027610	10.42	109.80	40.57	1.12
Reach-1	1900	PF 1	1144.00	4567.47	4573.38	4573.17	4574.61	0.017941	8.90	128.60	43.51	0.81
Reach-1	1800	PF 1	1144.00	4565.67	4571.59	4571.37	4572.89	0.018223	9.13	125.27	41.03	0.92
Reach-1	1700	PF 1	1144.00	4562.93	4569.01	4568.70	4570.21	0.017017	8.81	129.84	42.67	0.89

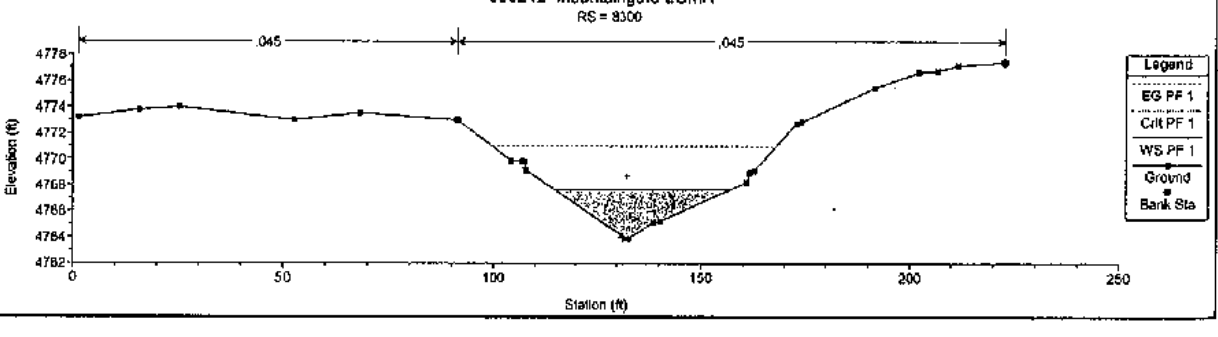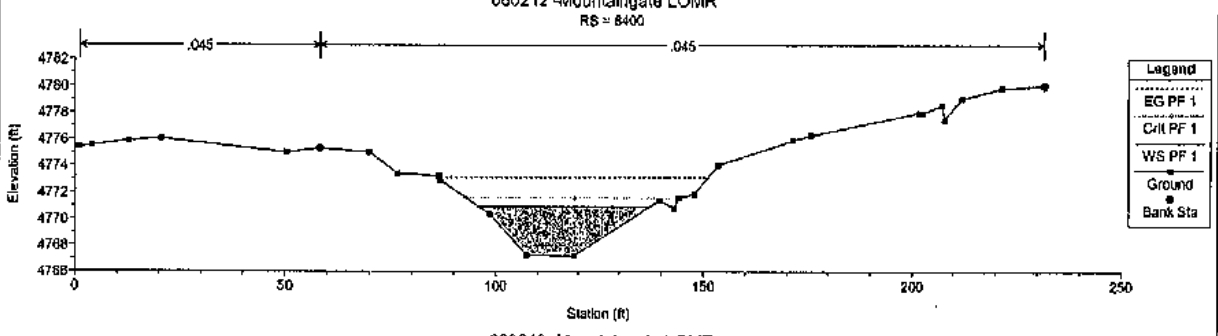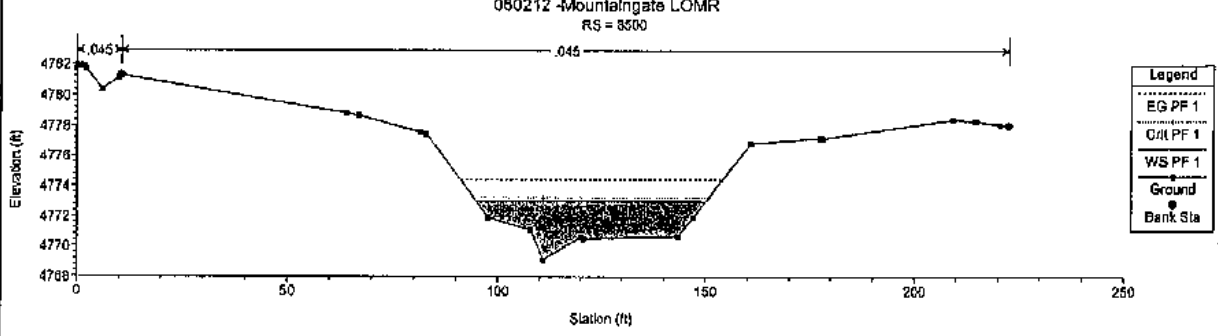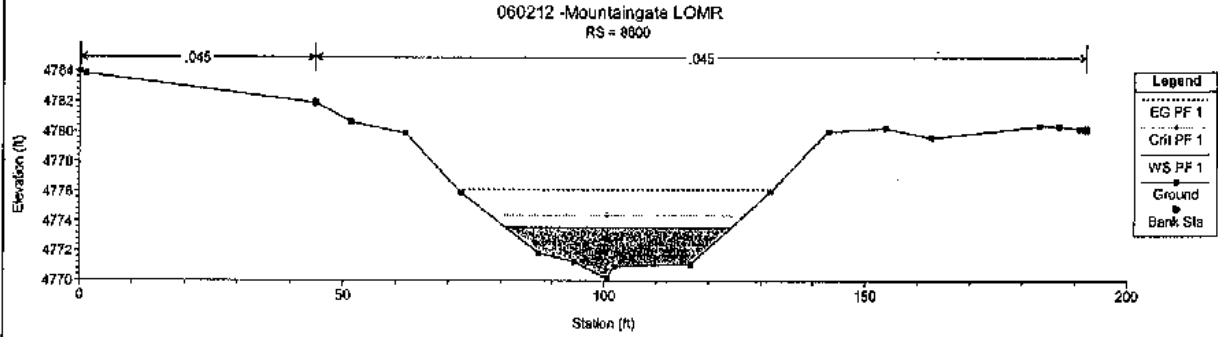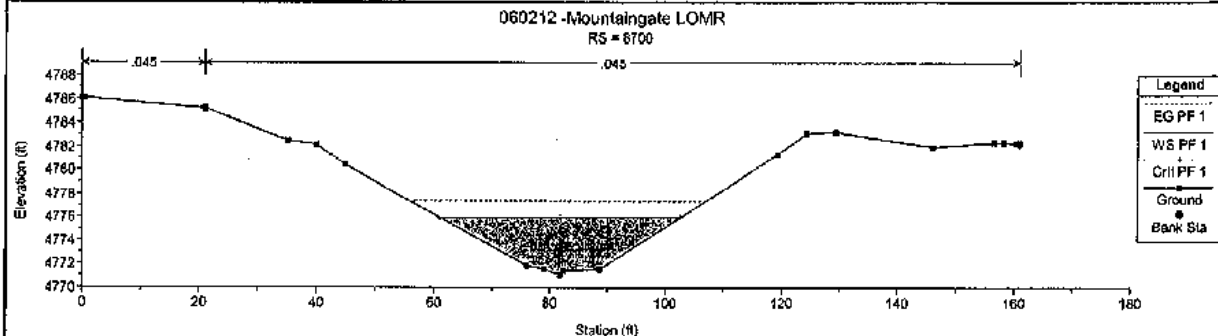


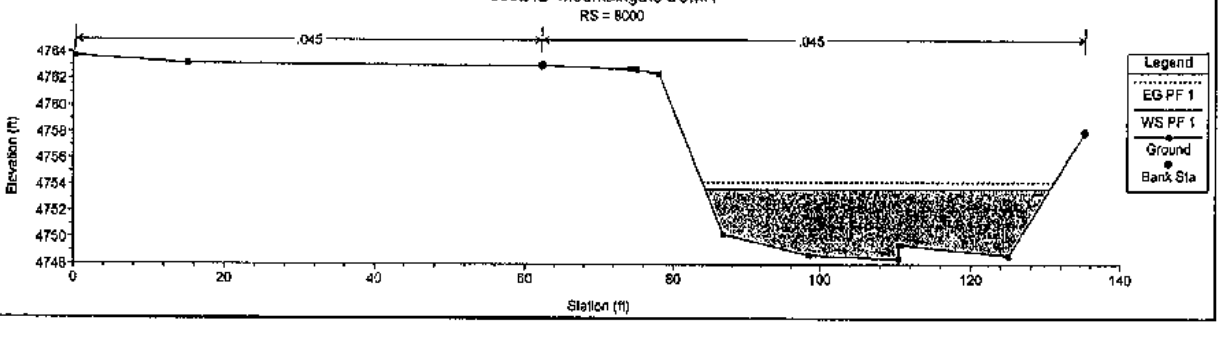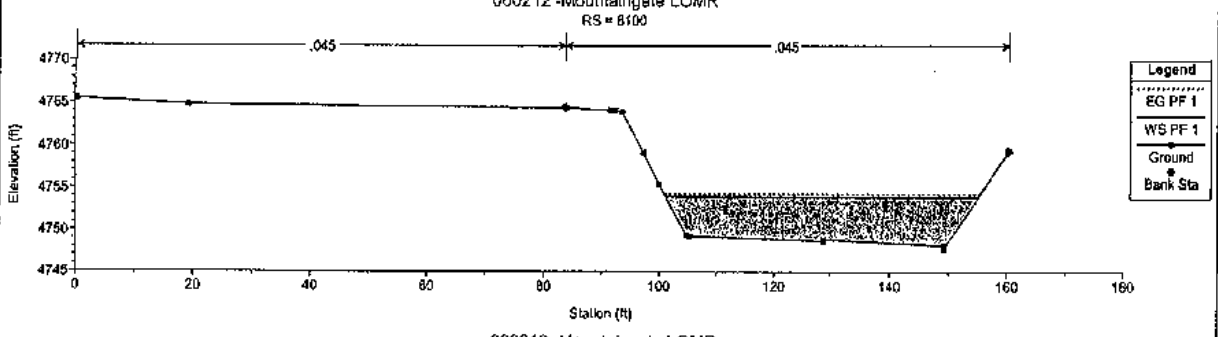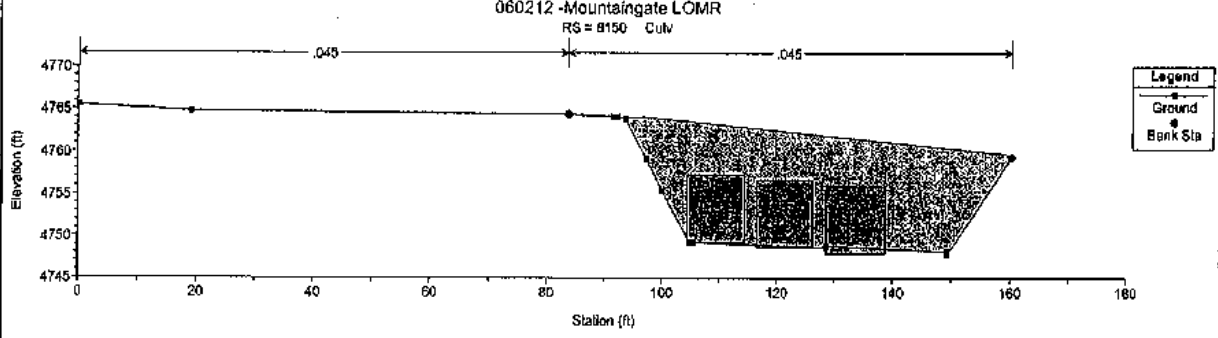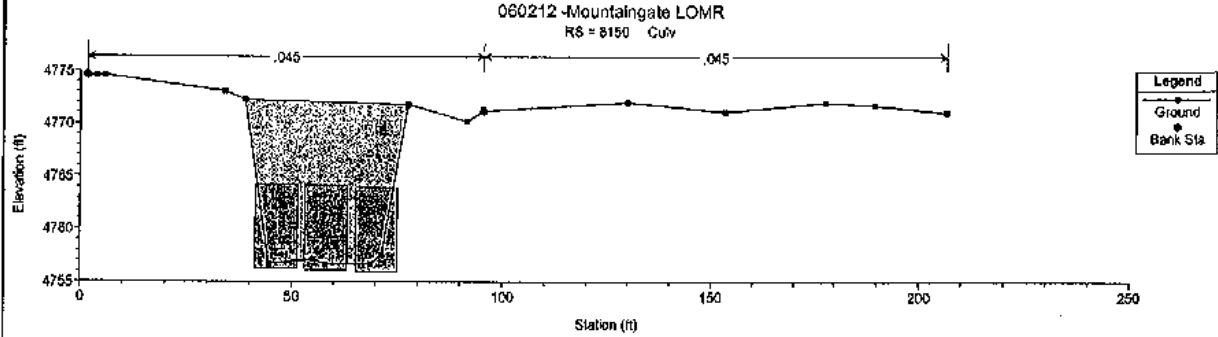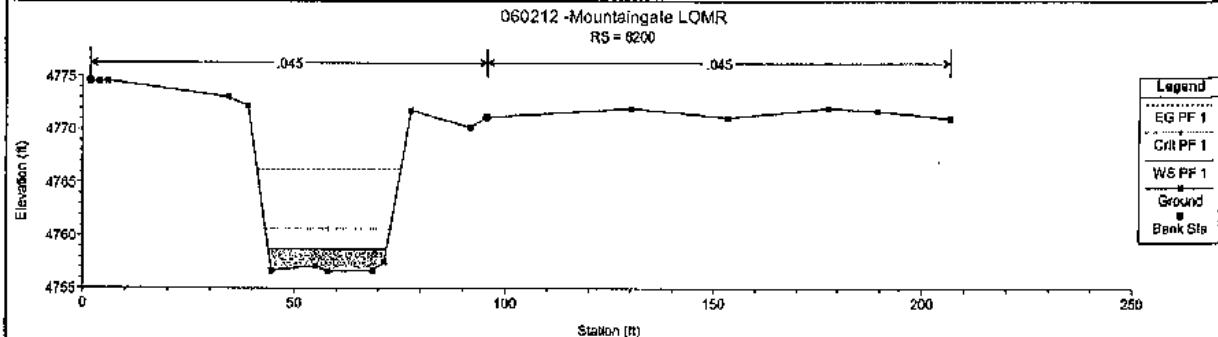


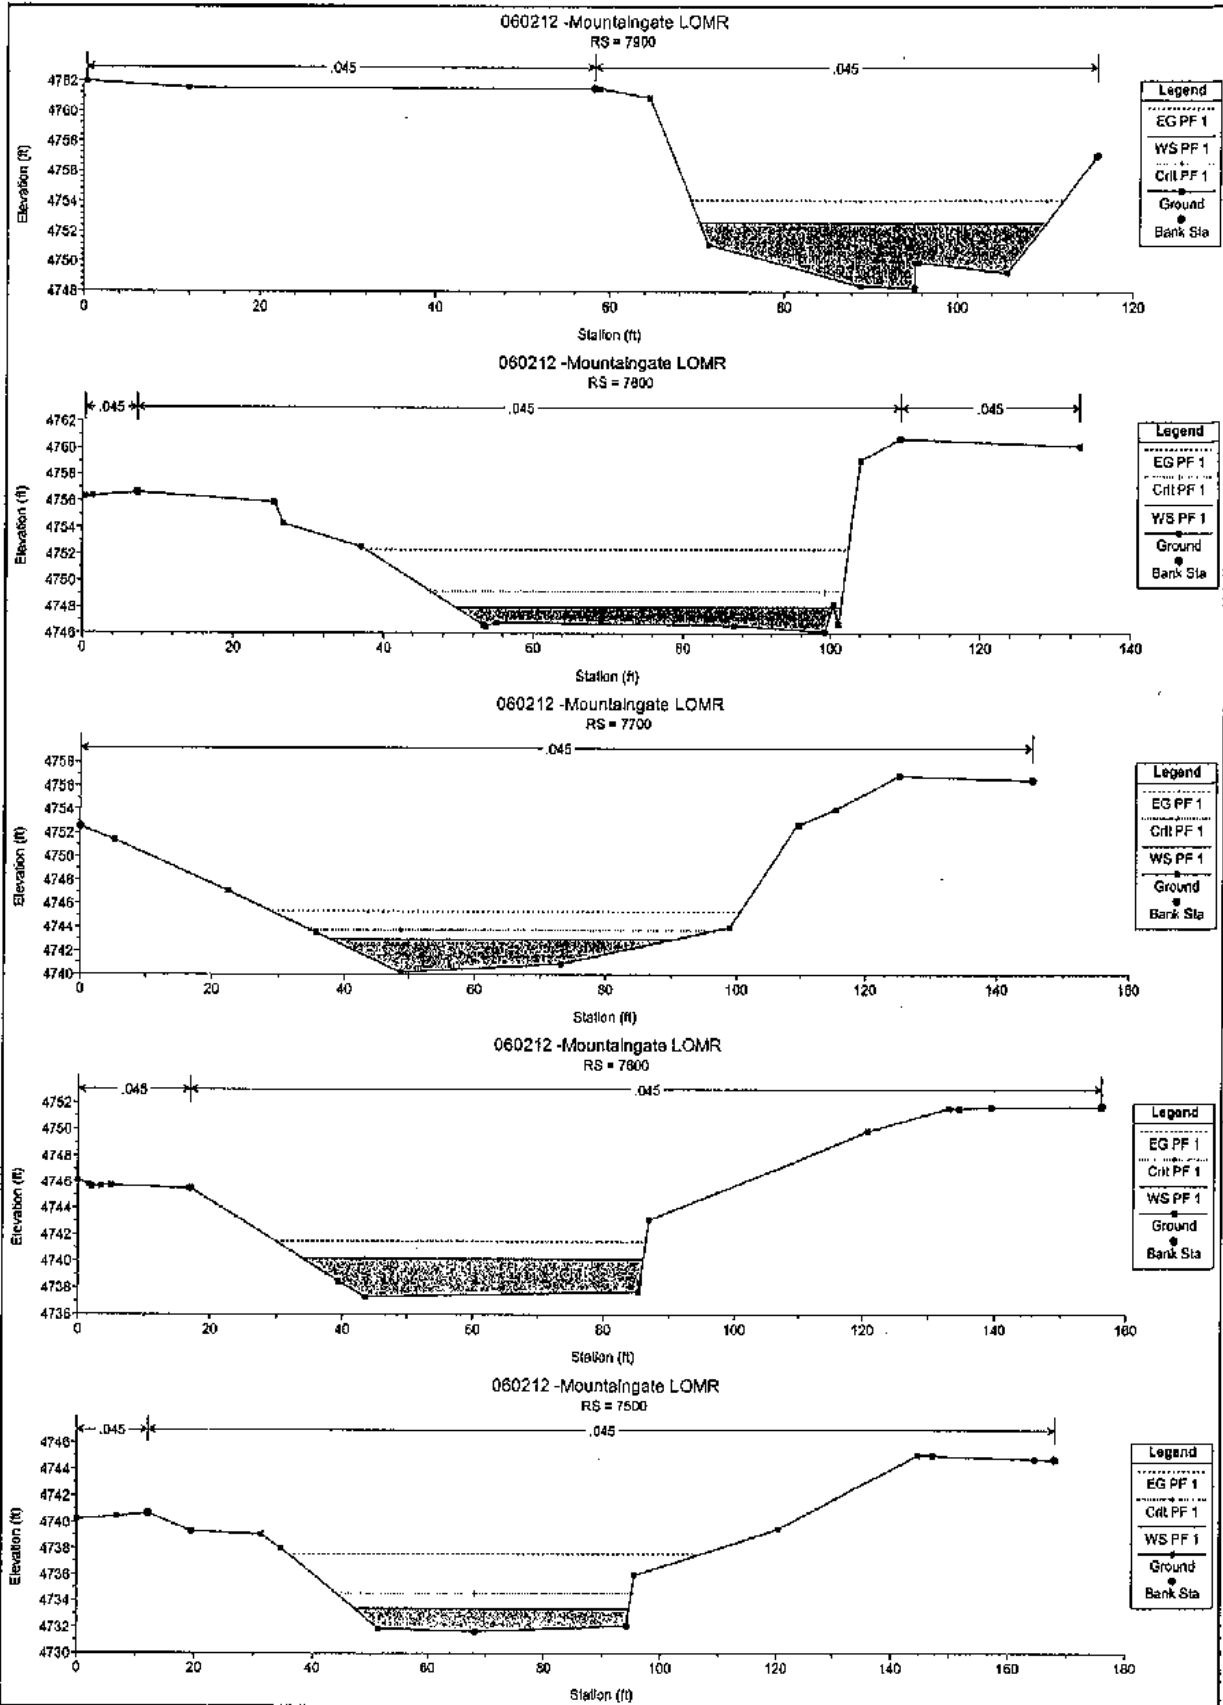


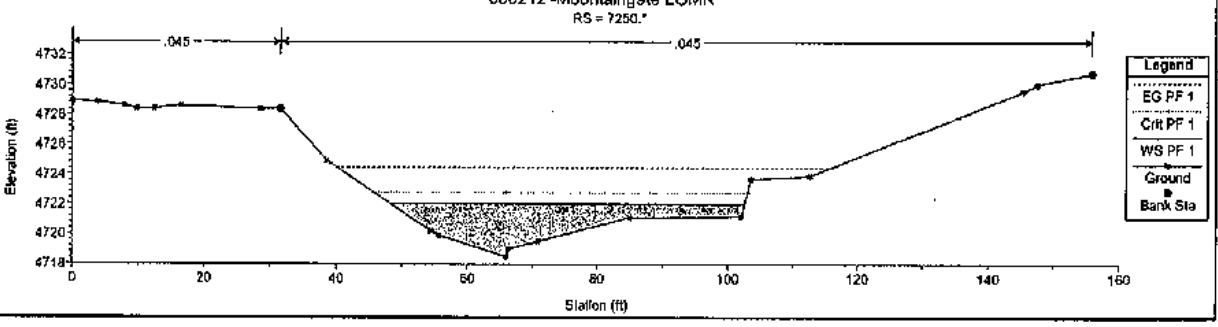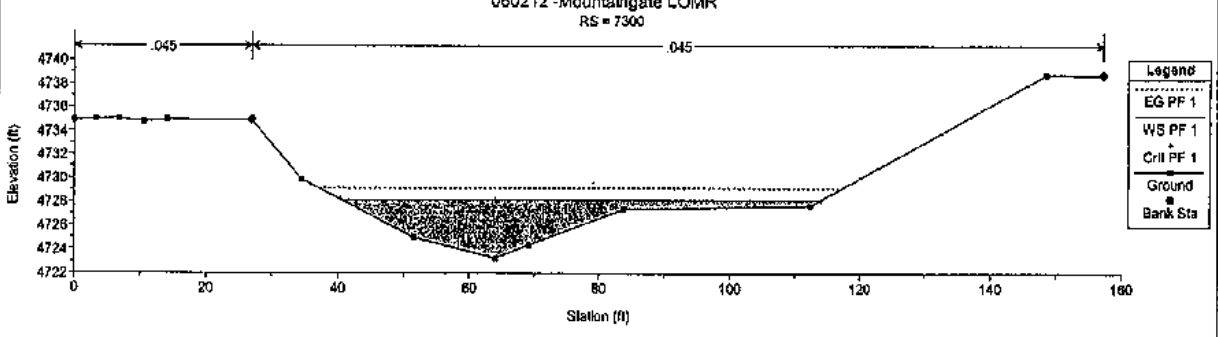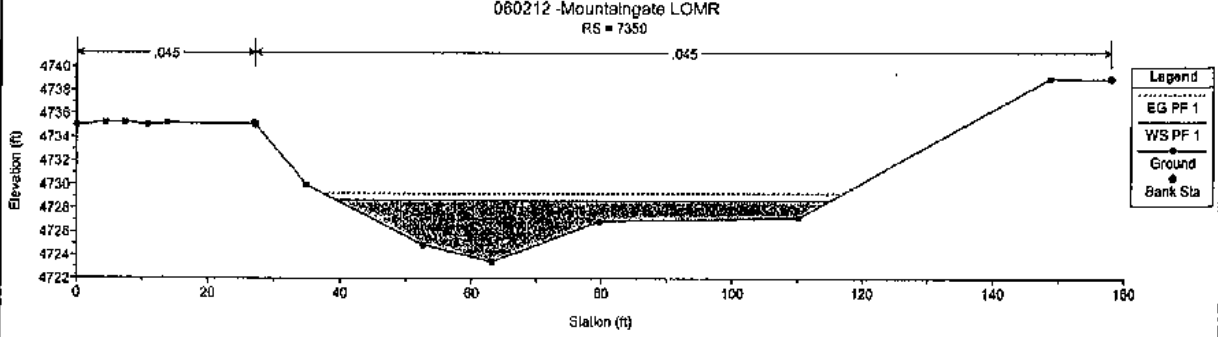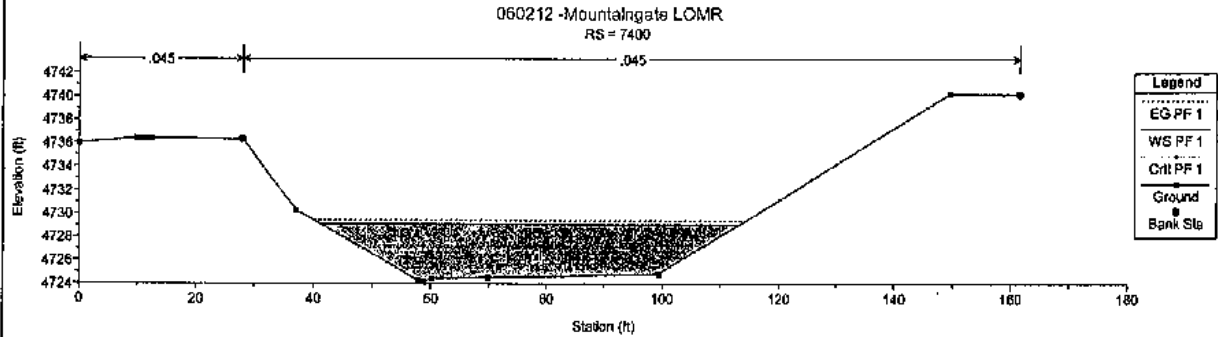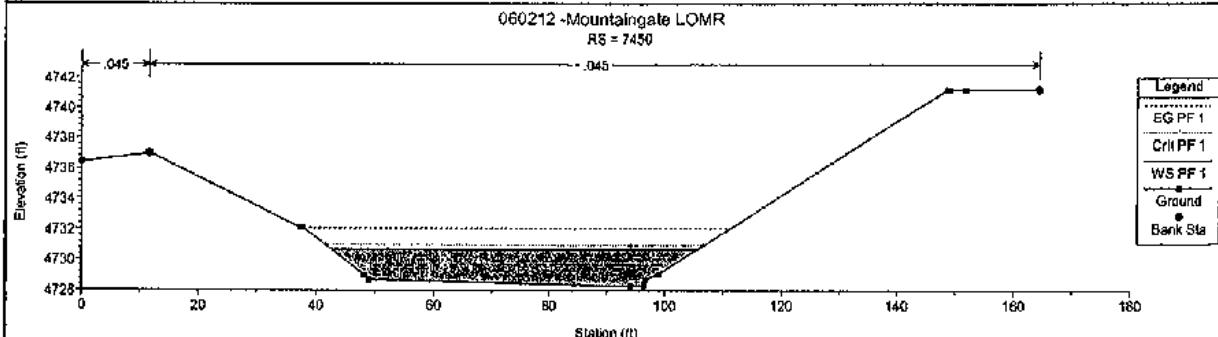






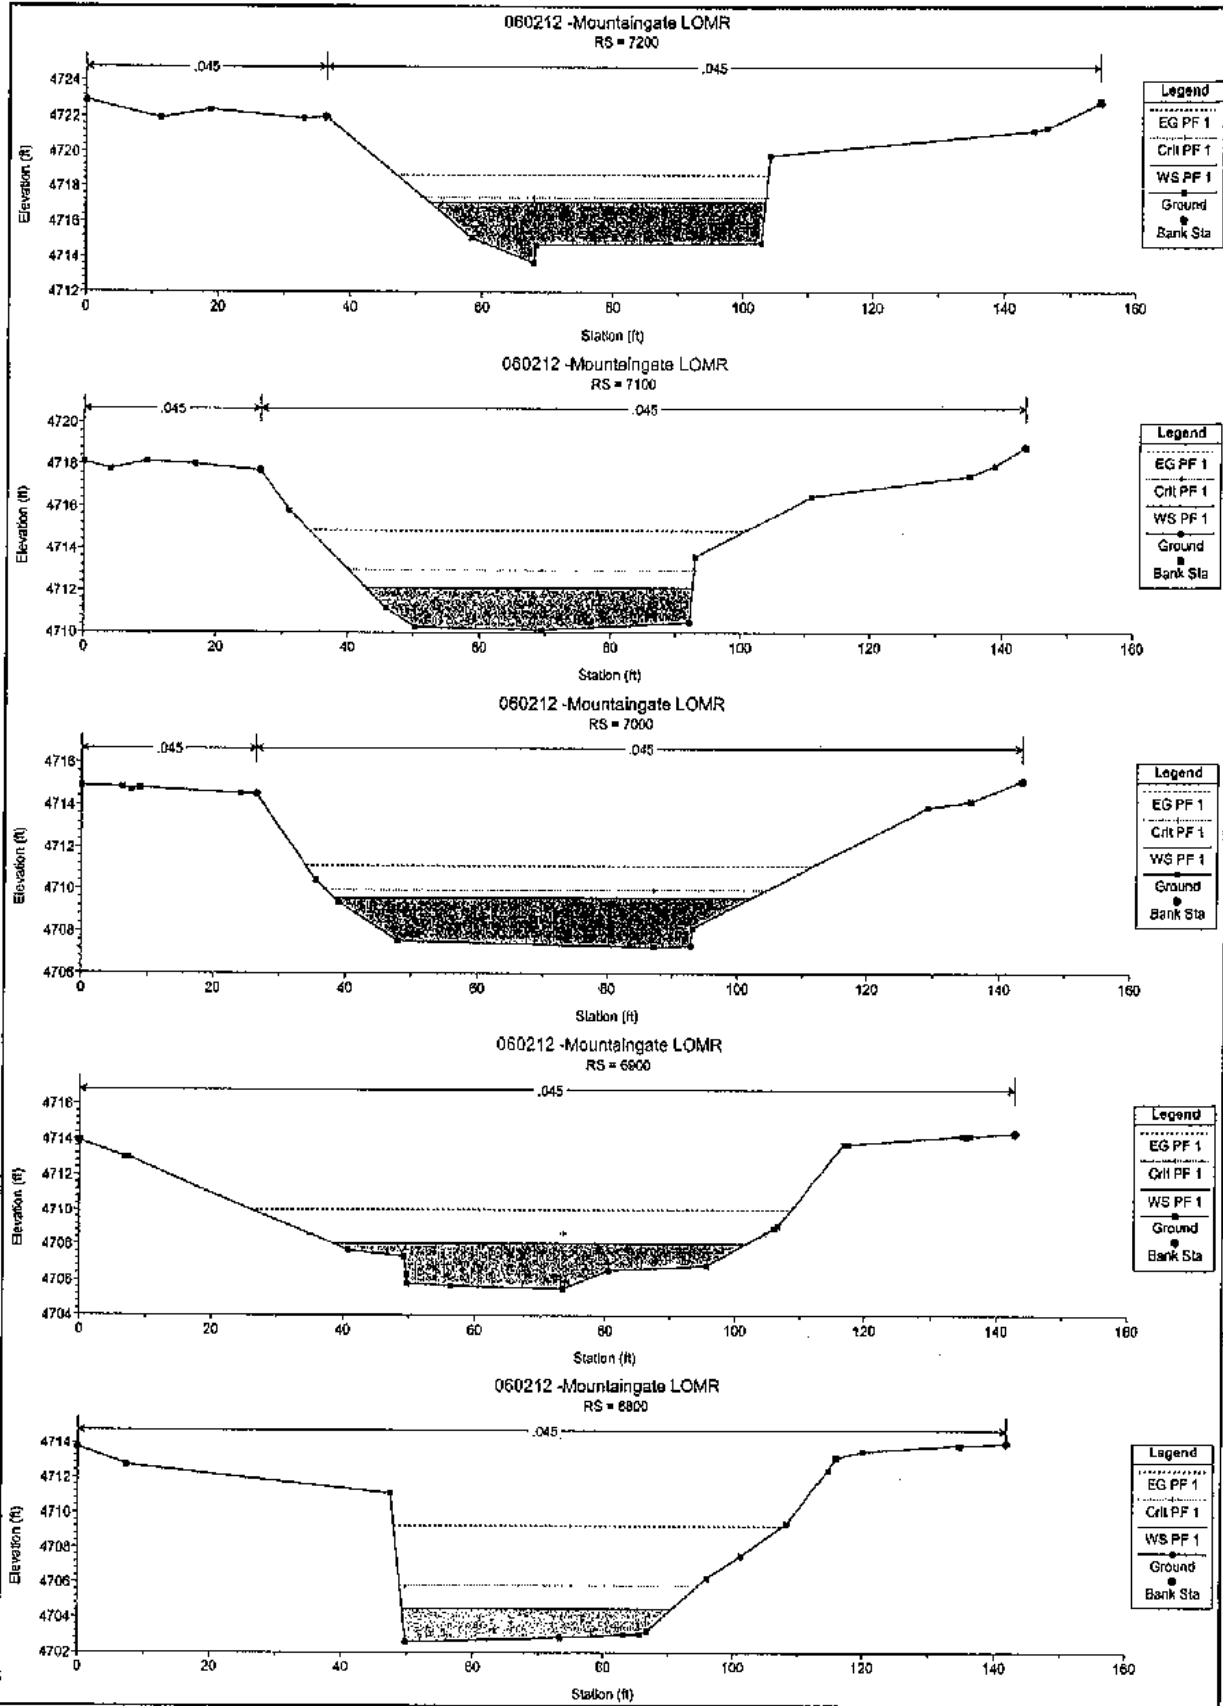


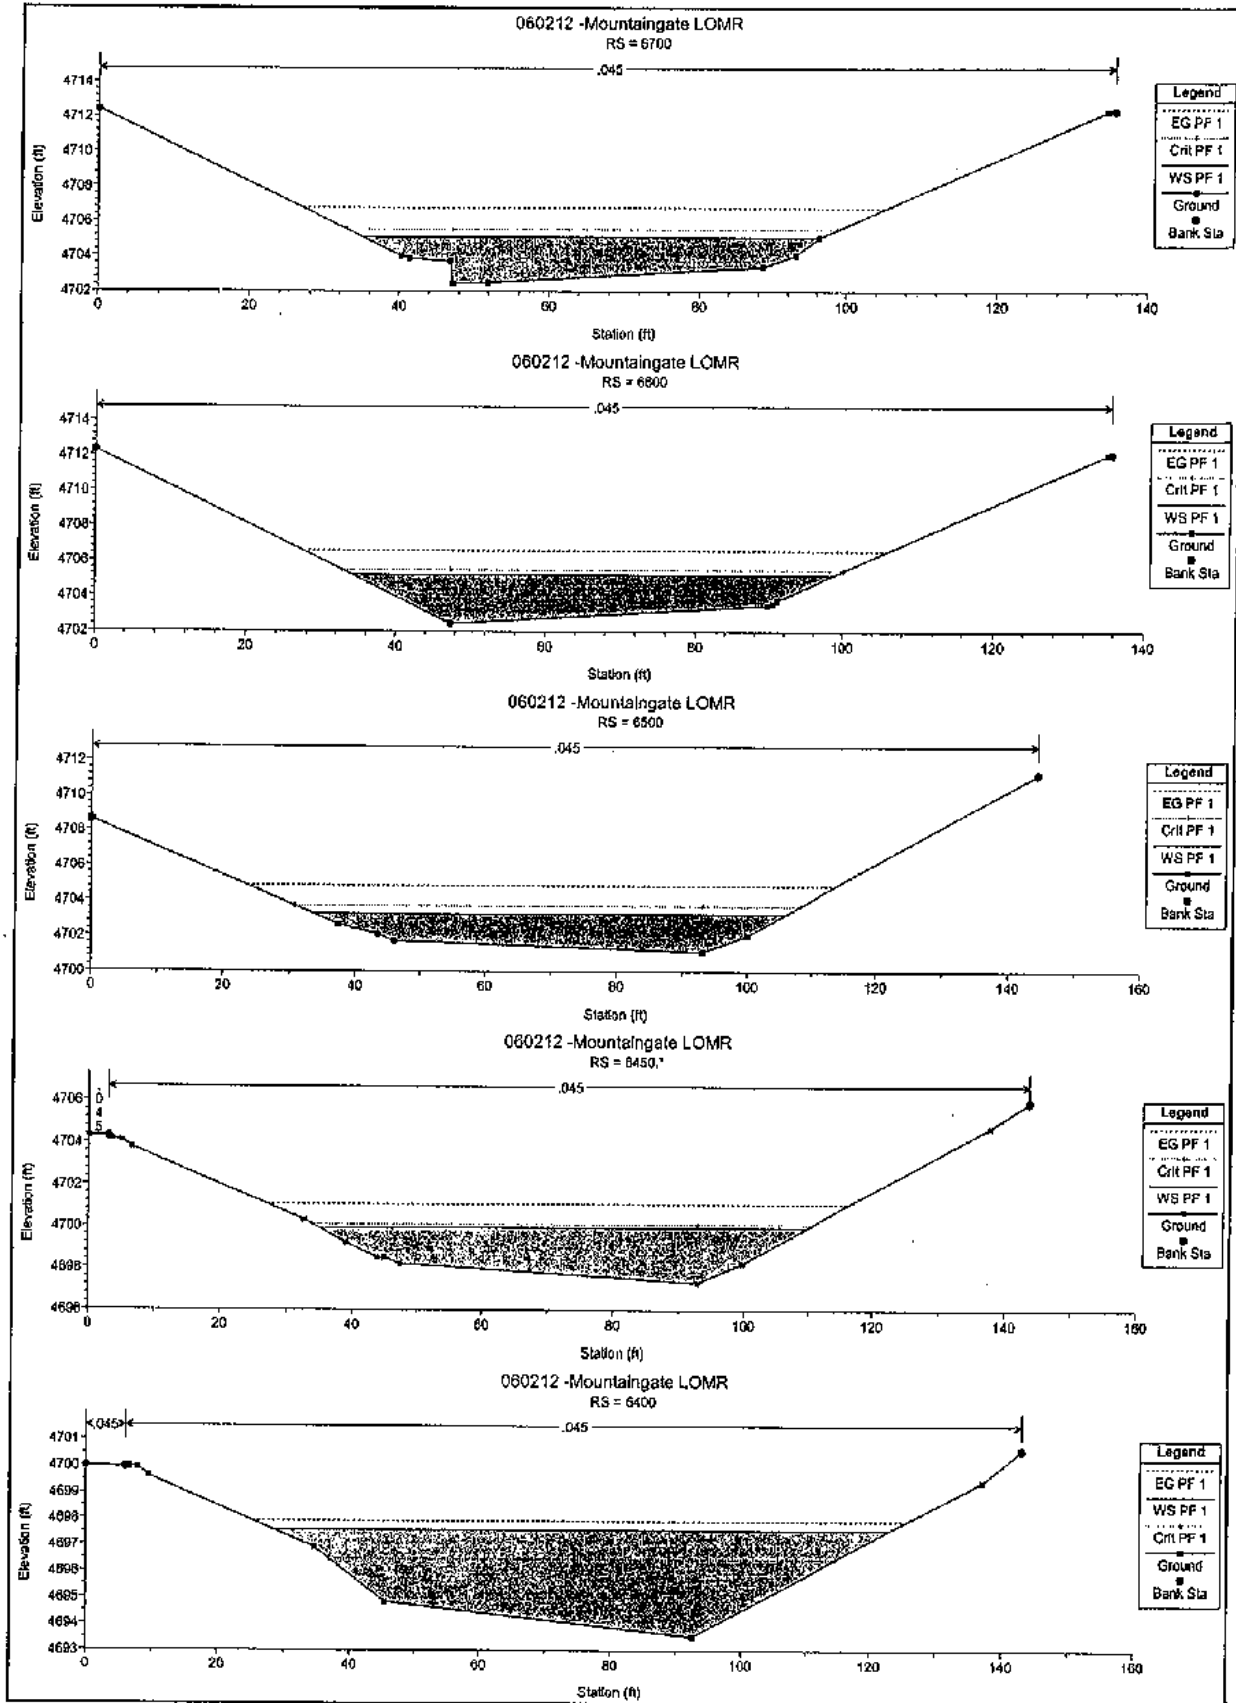


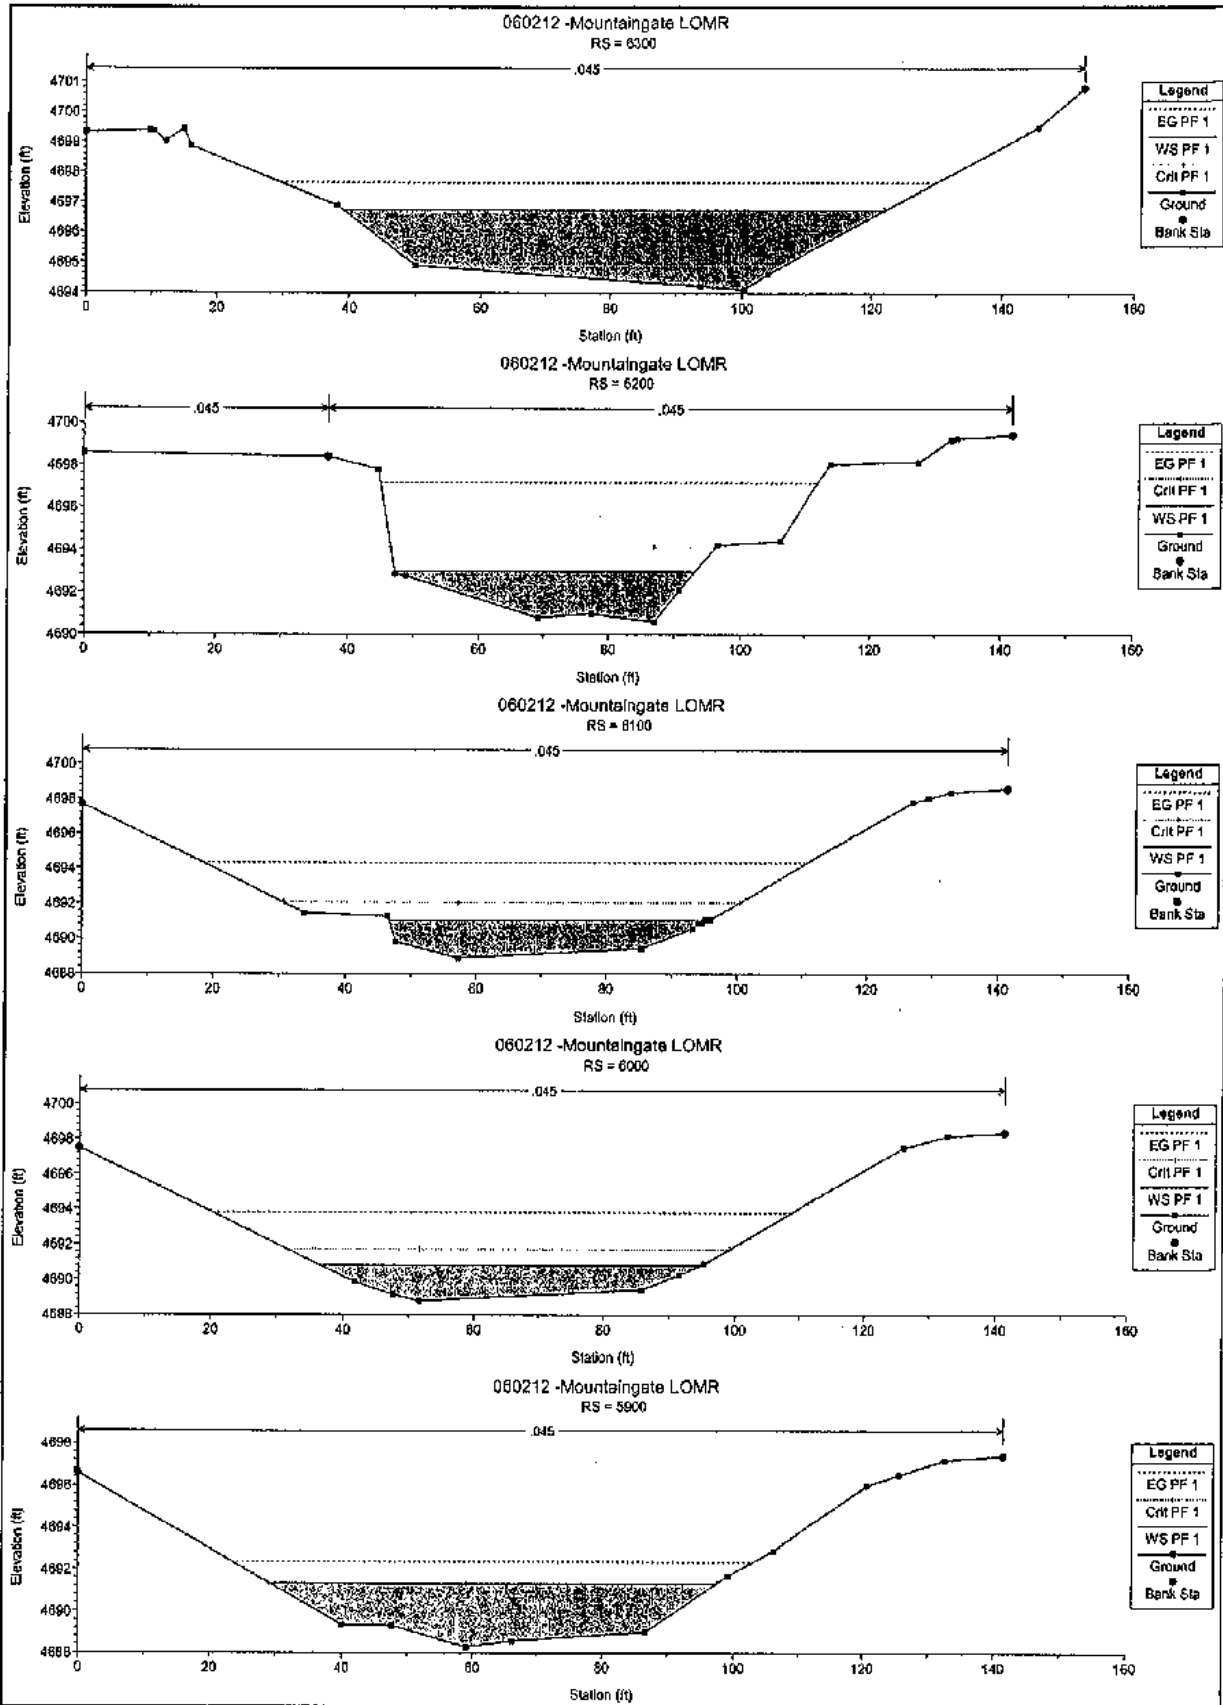






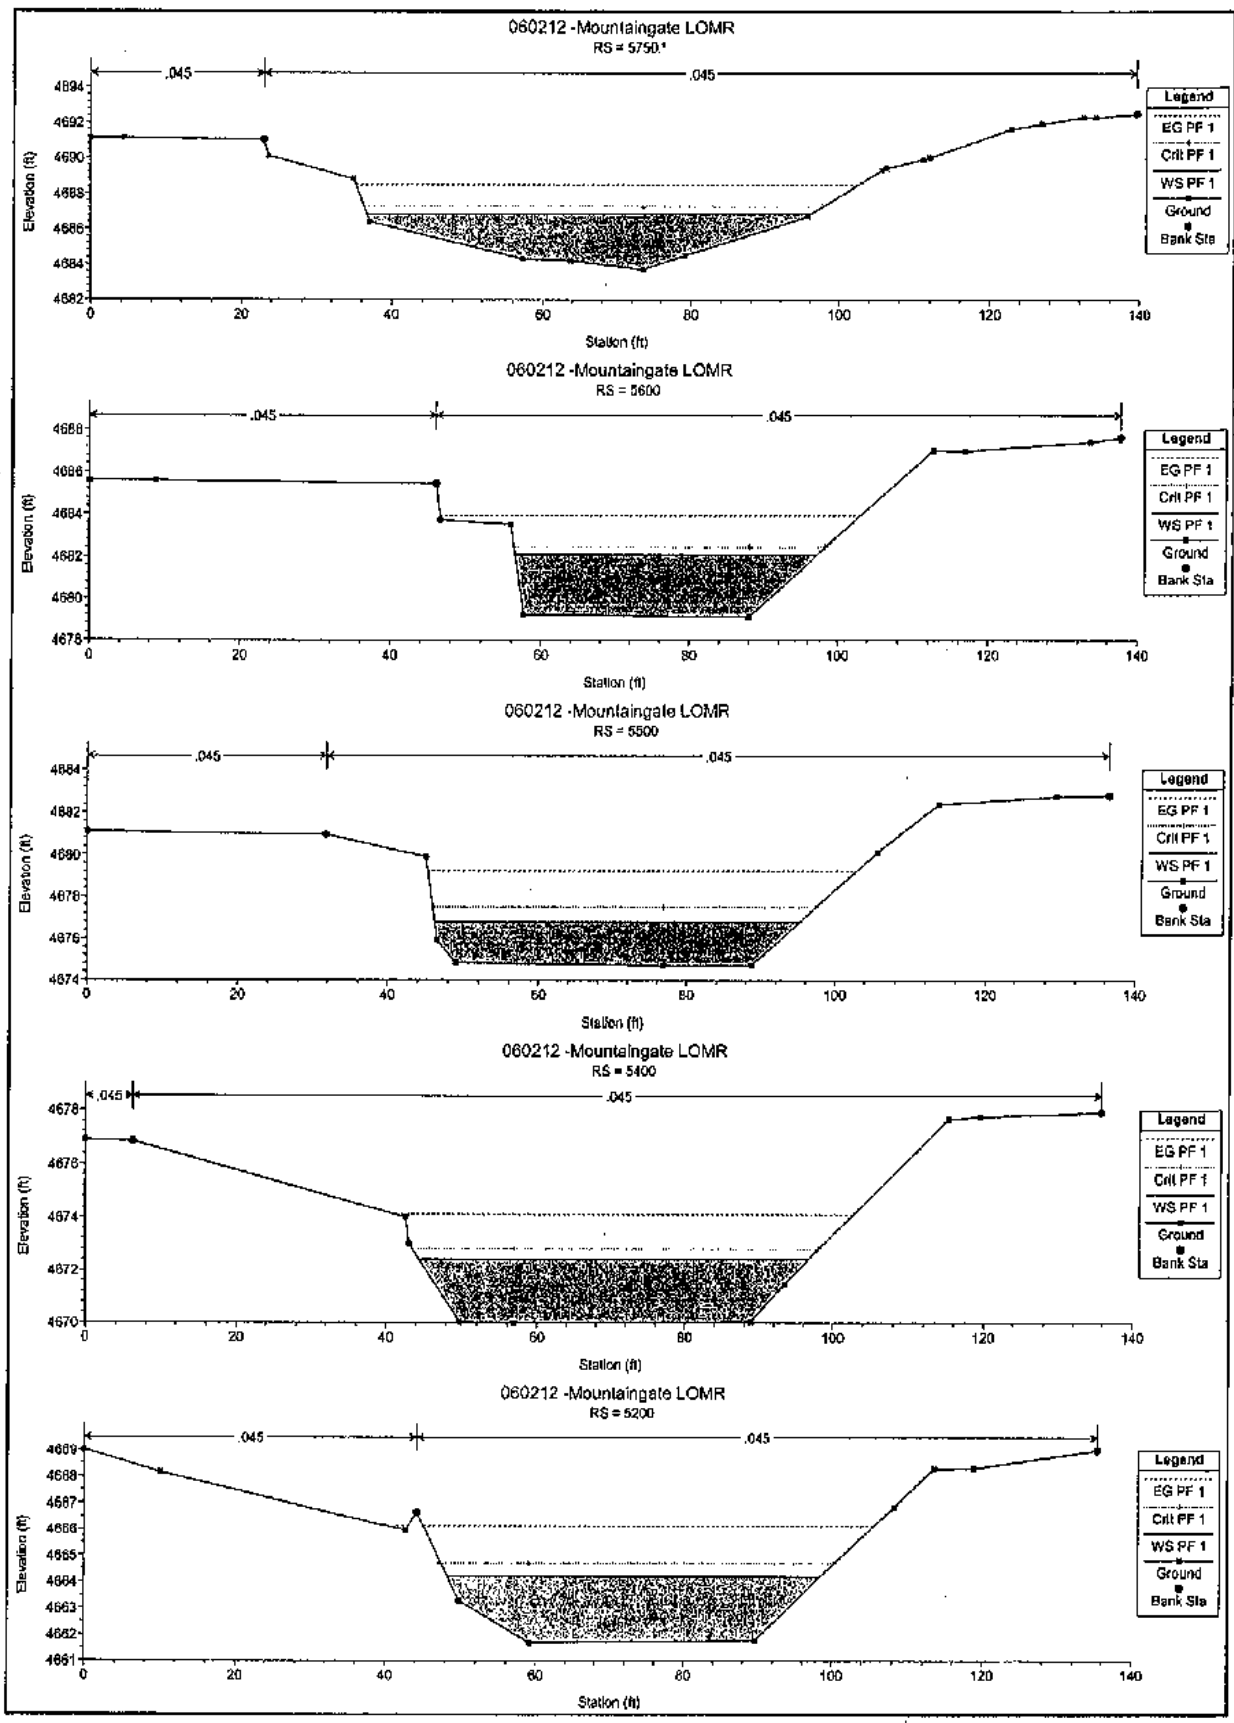


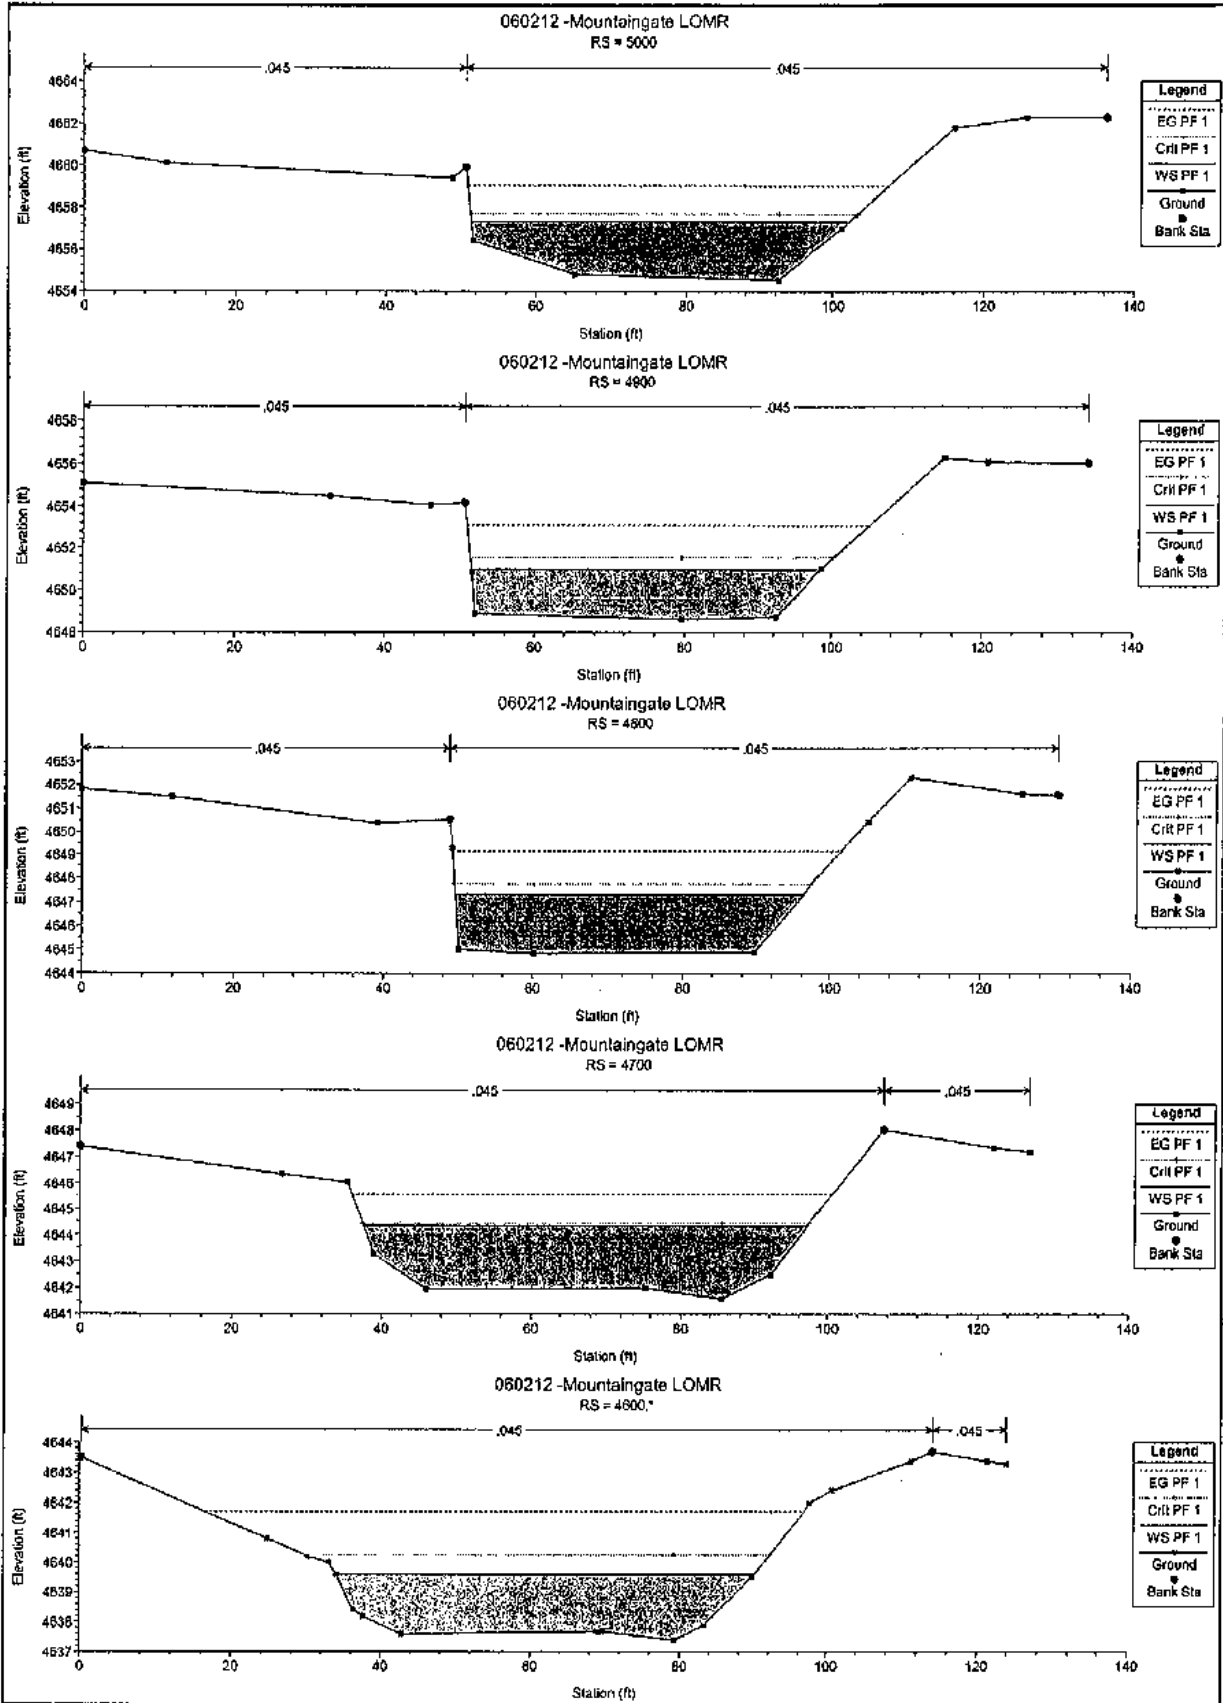


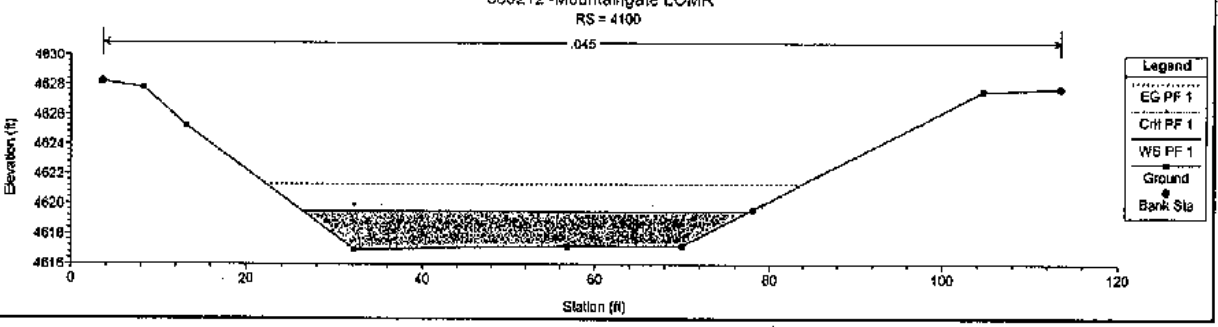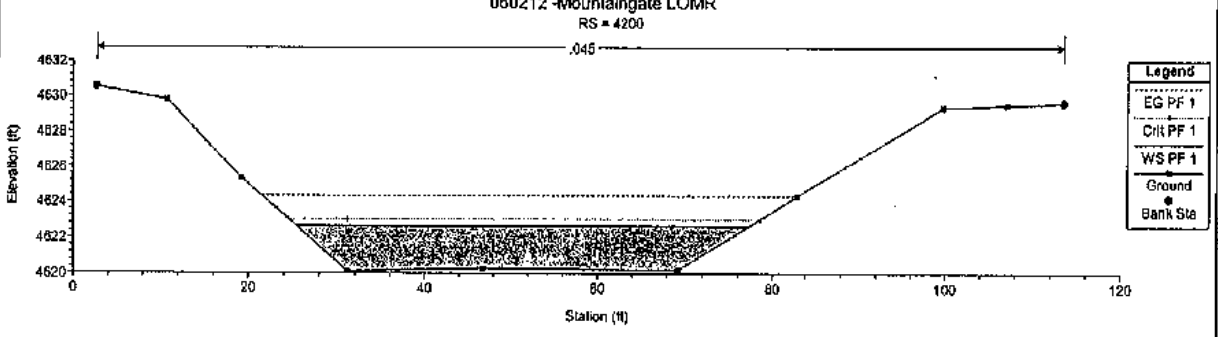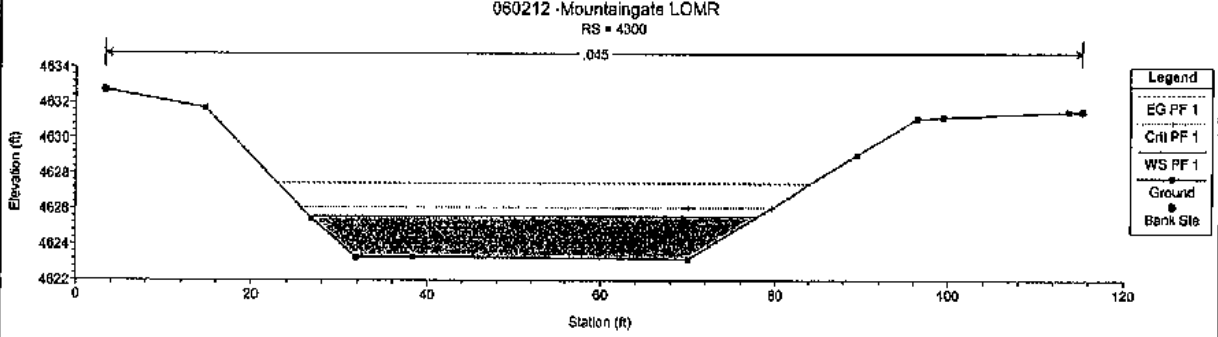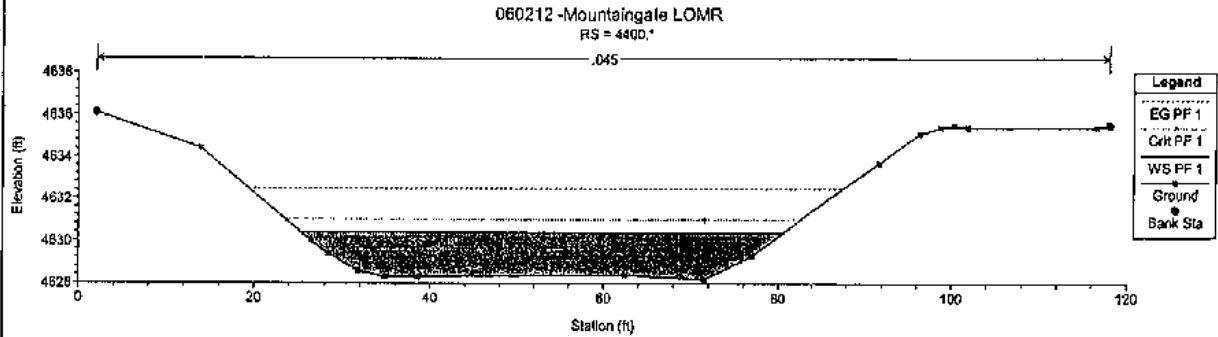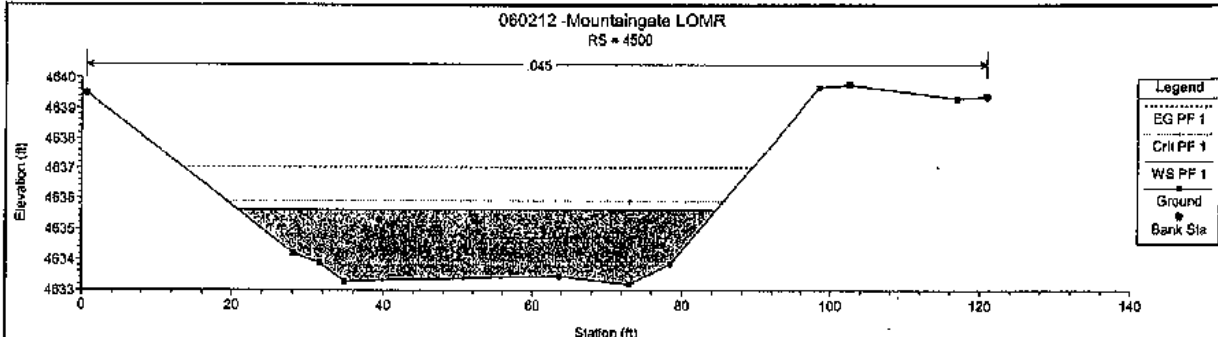


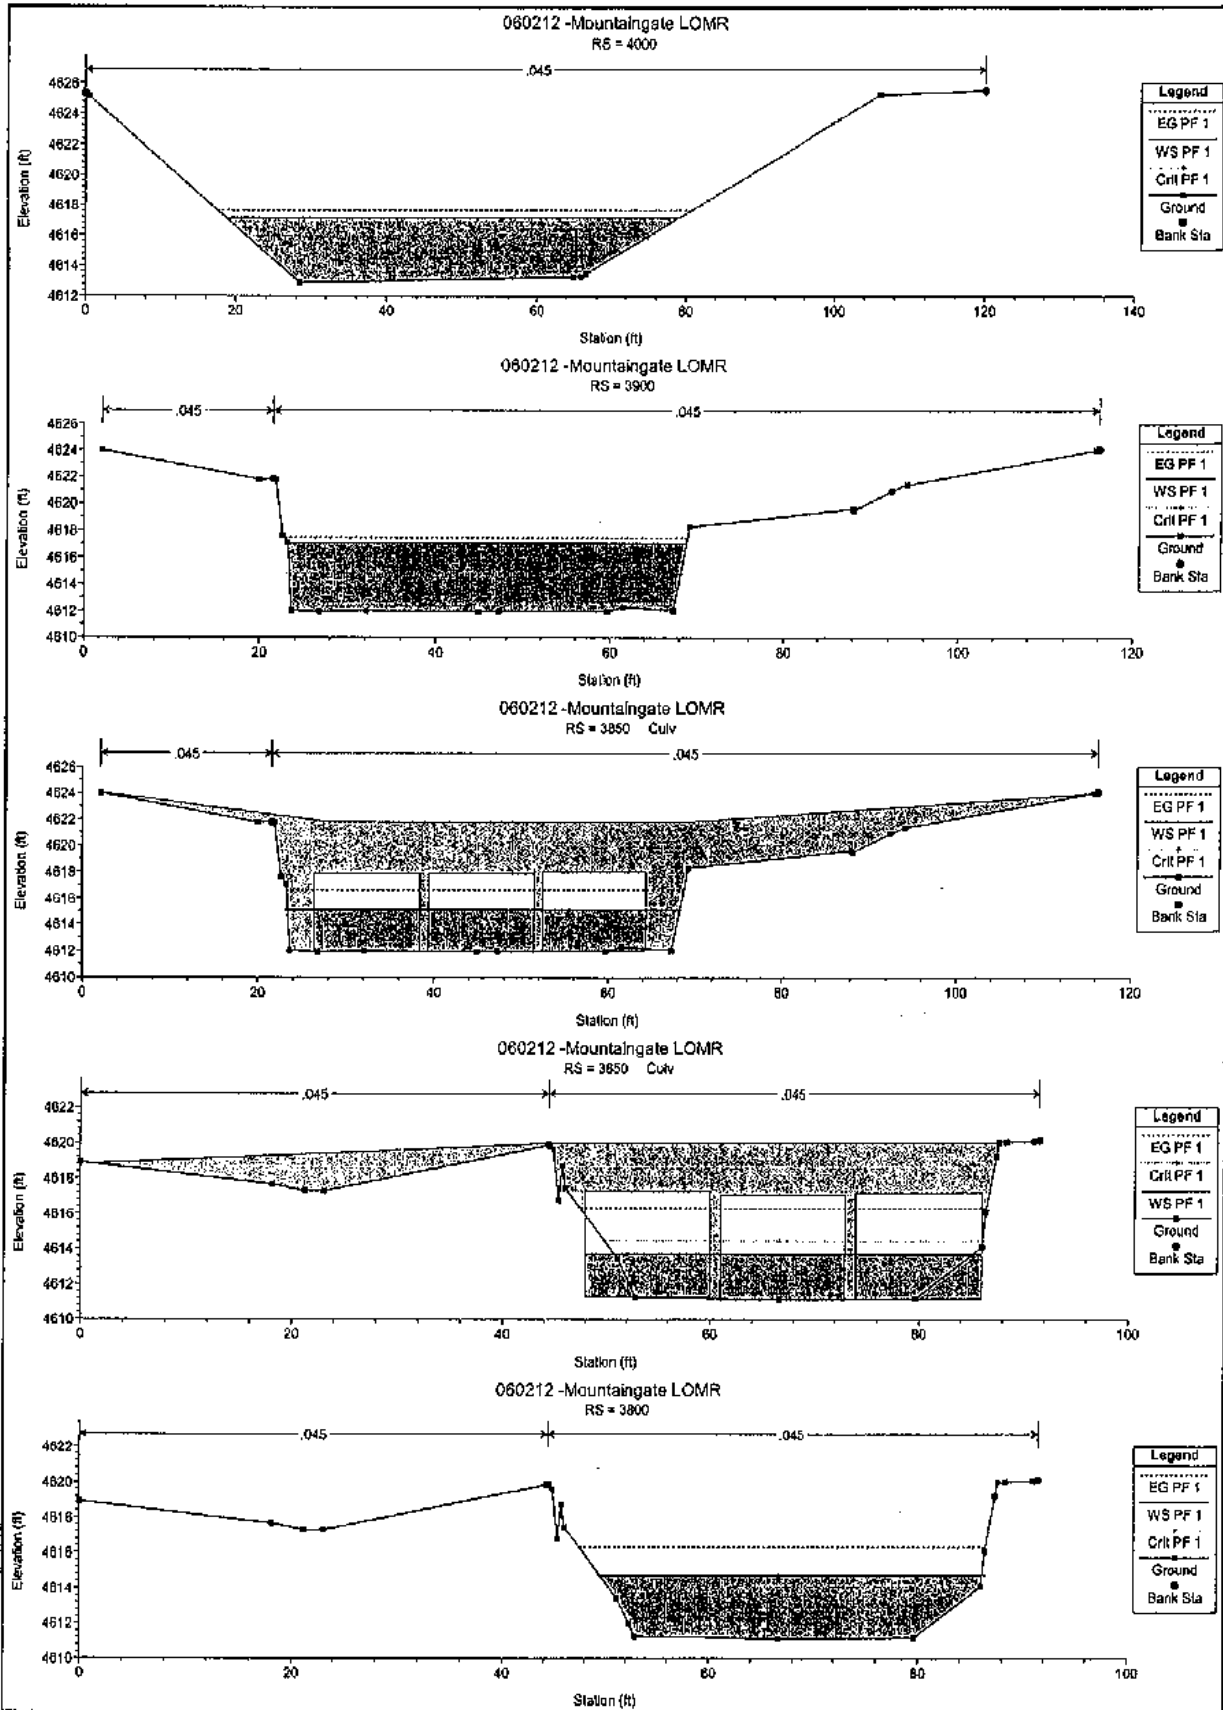

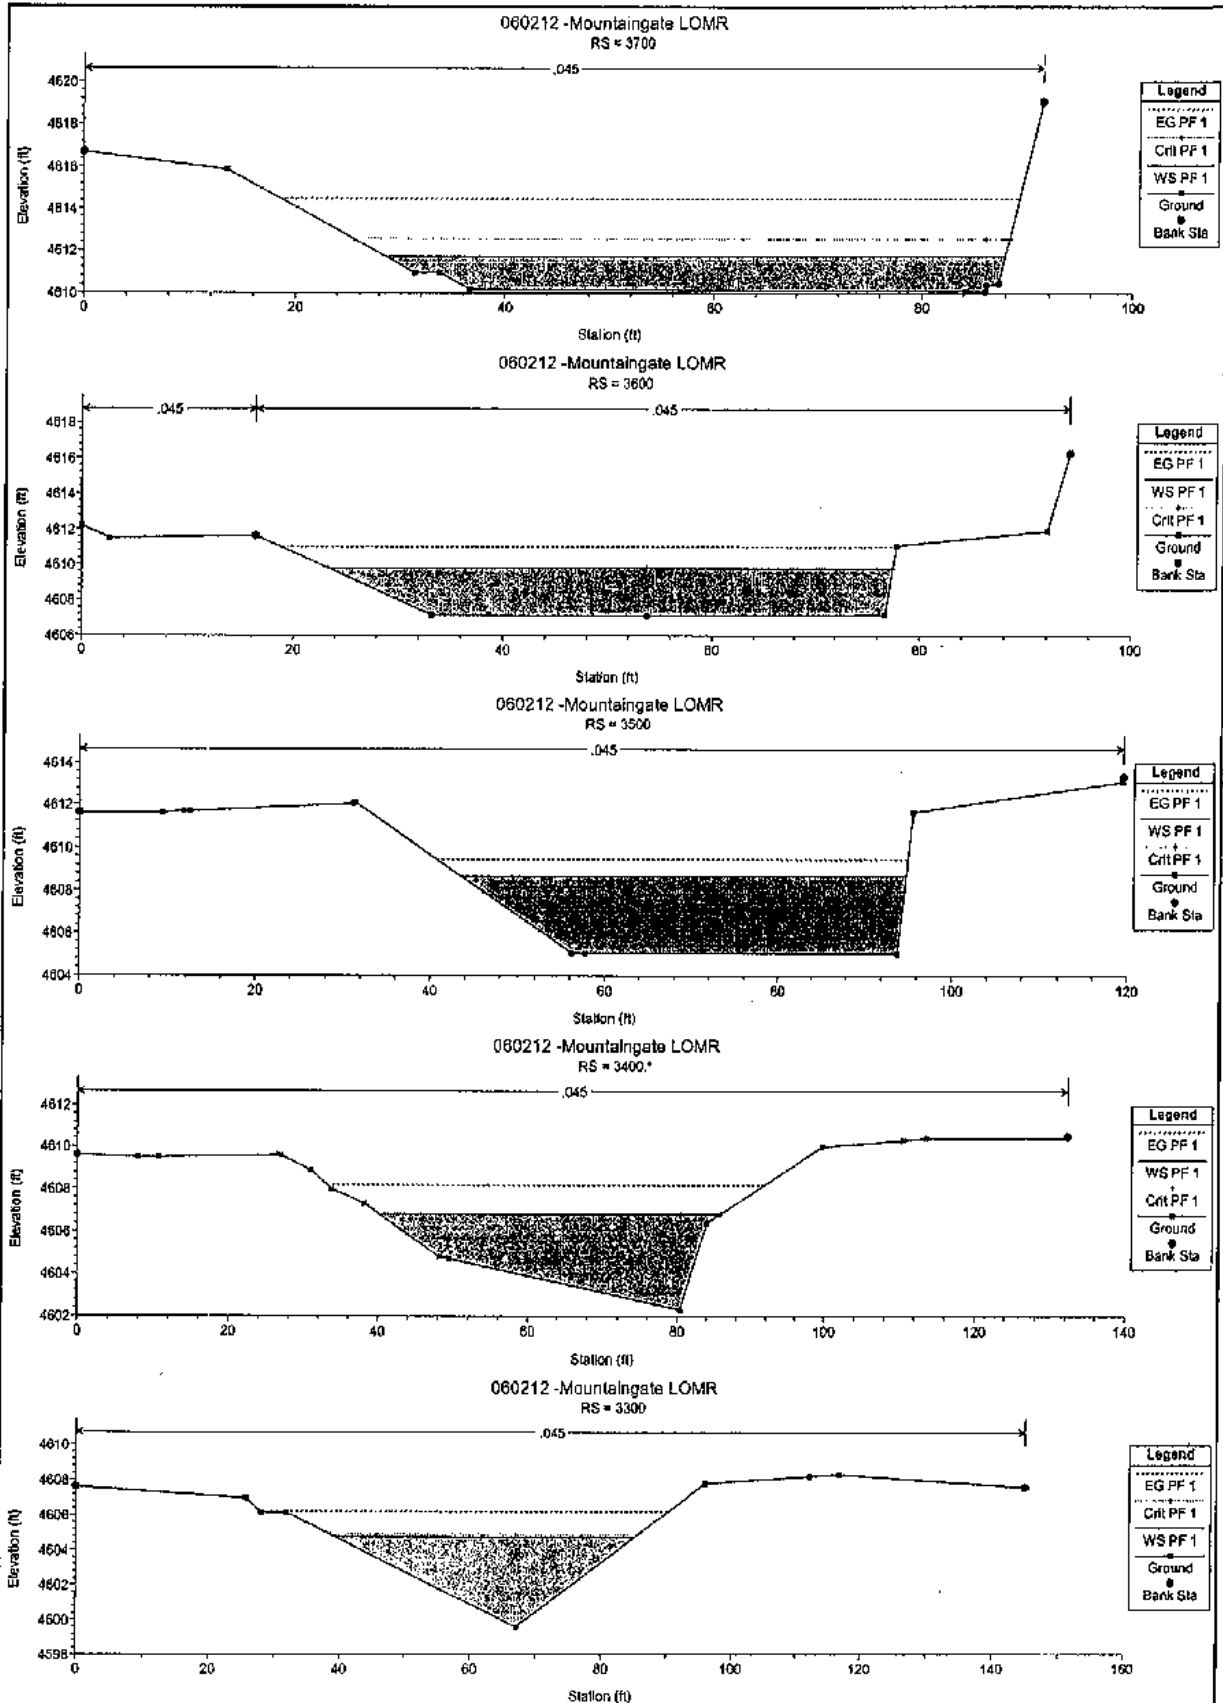


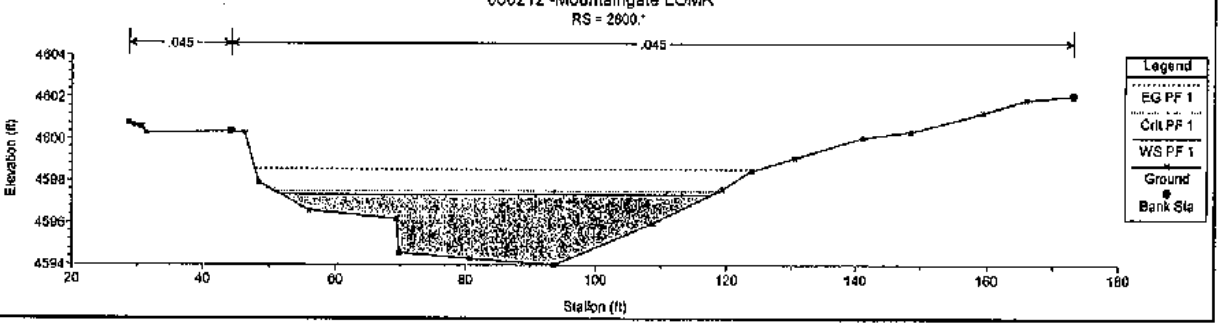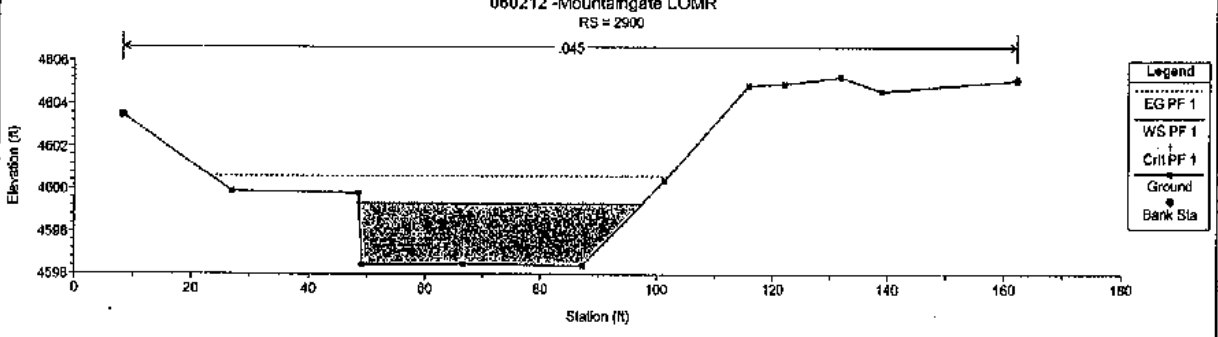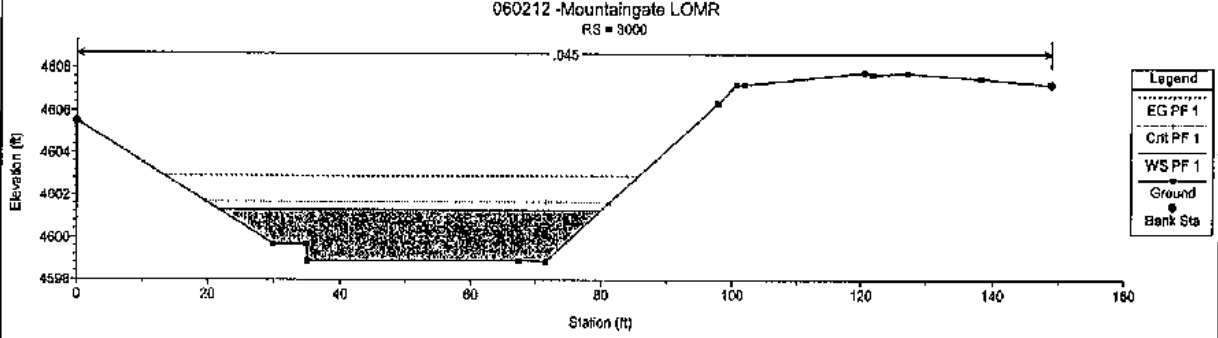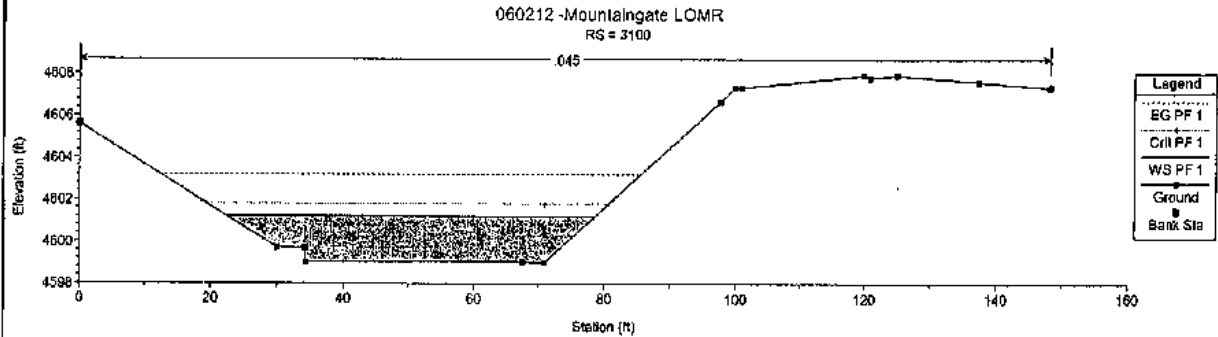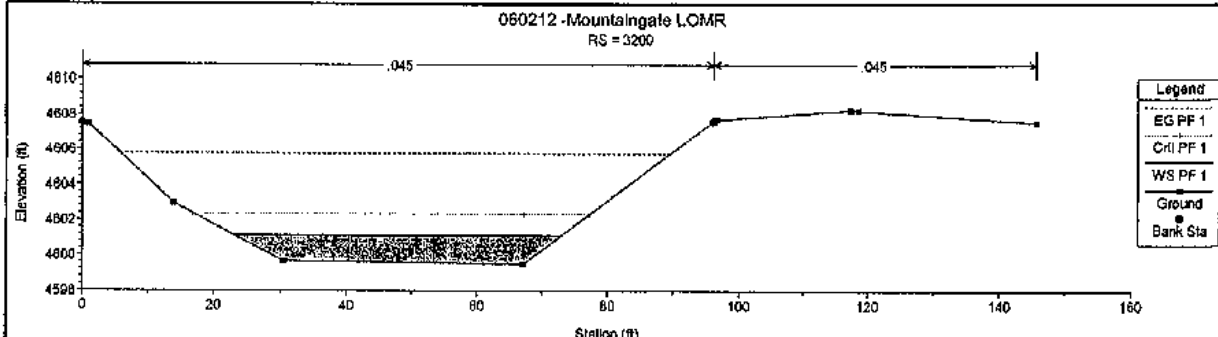

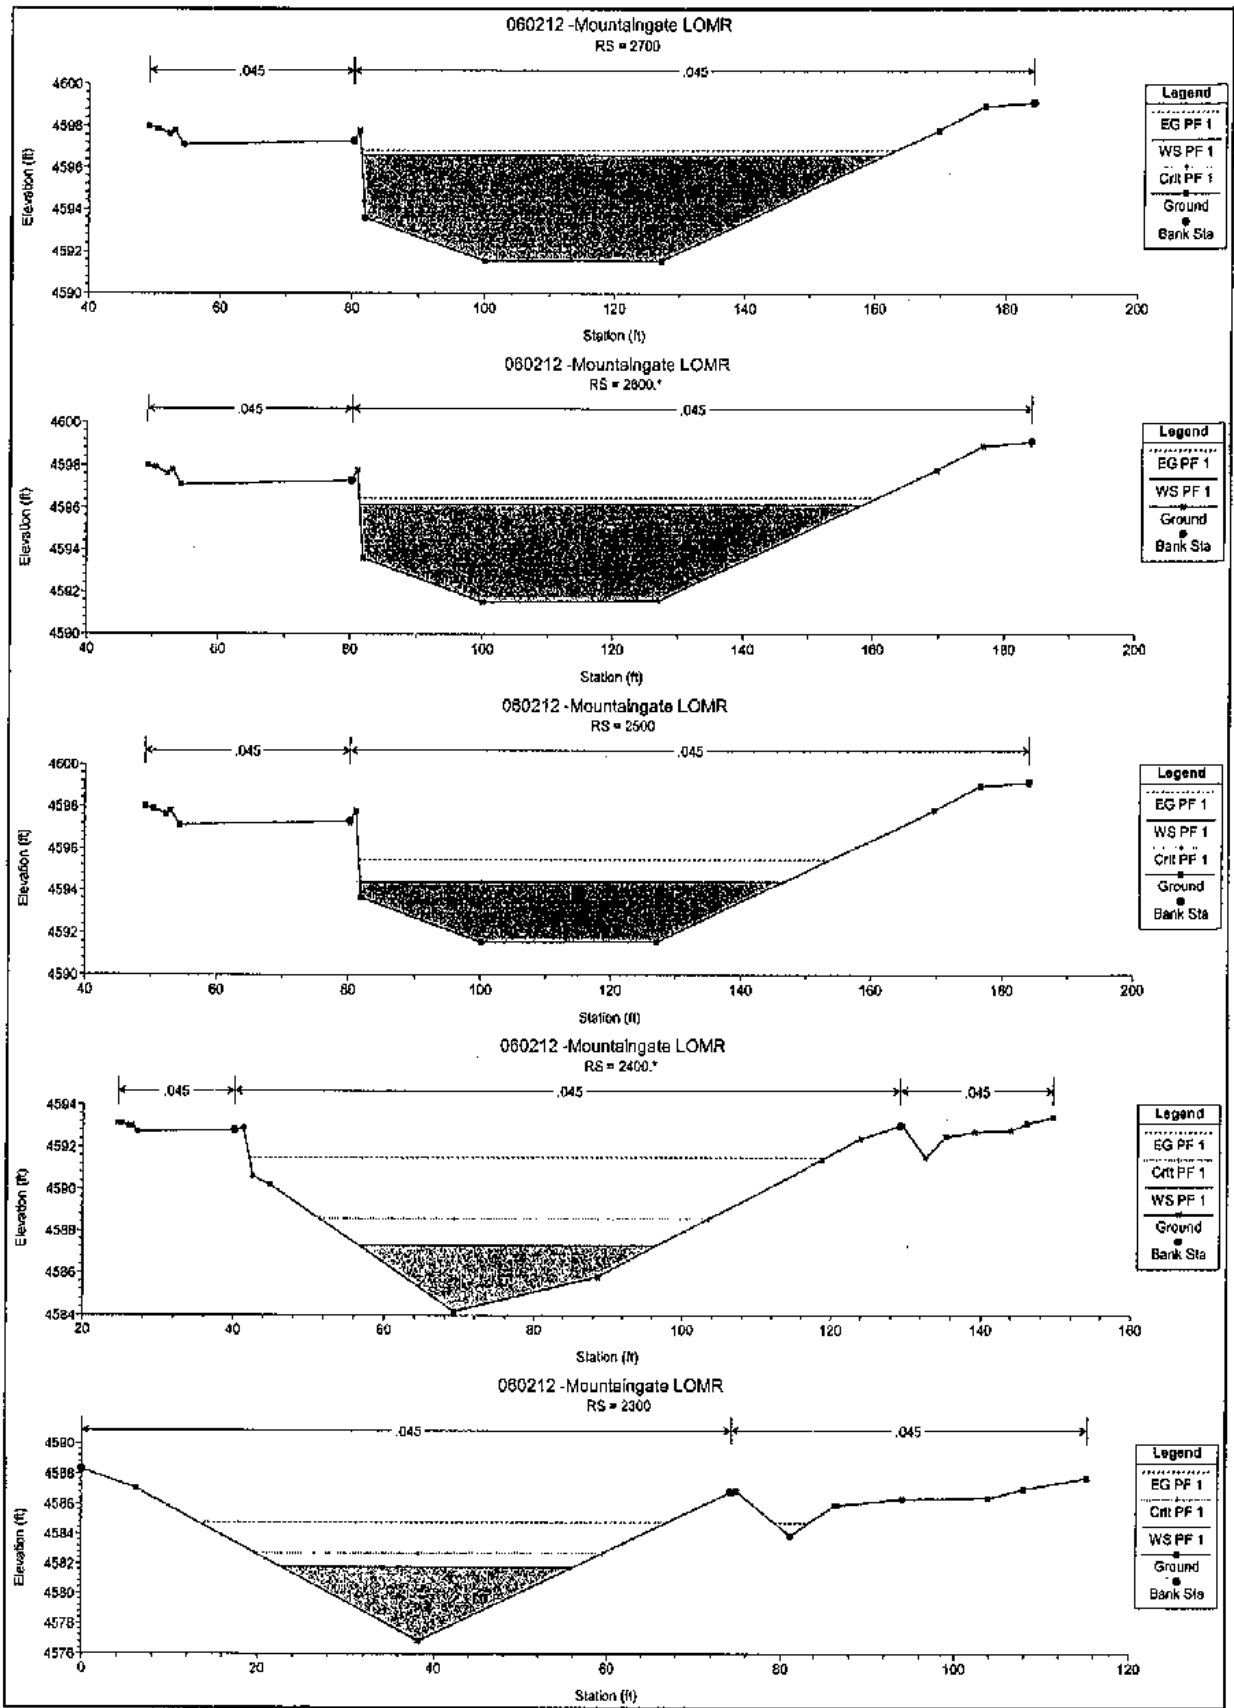


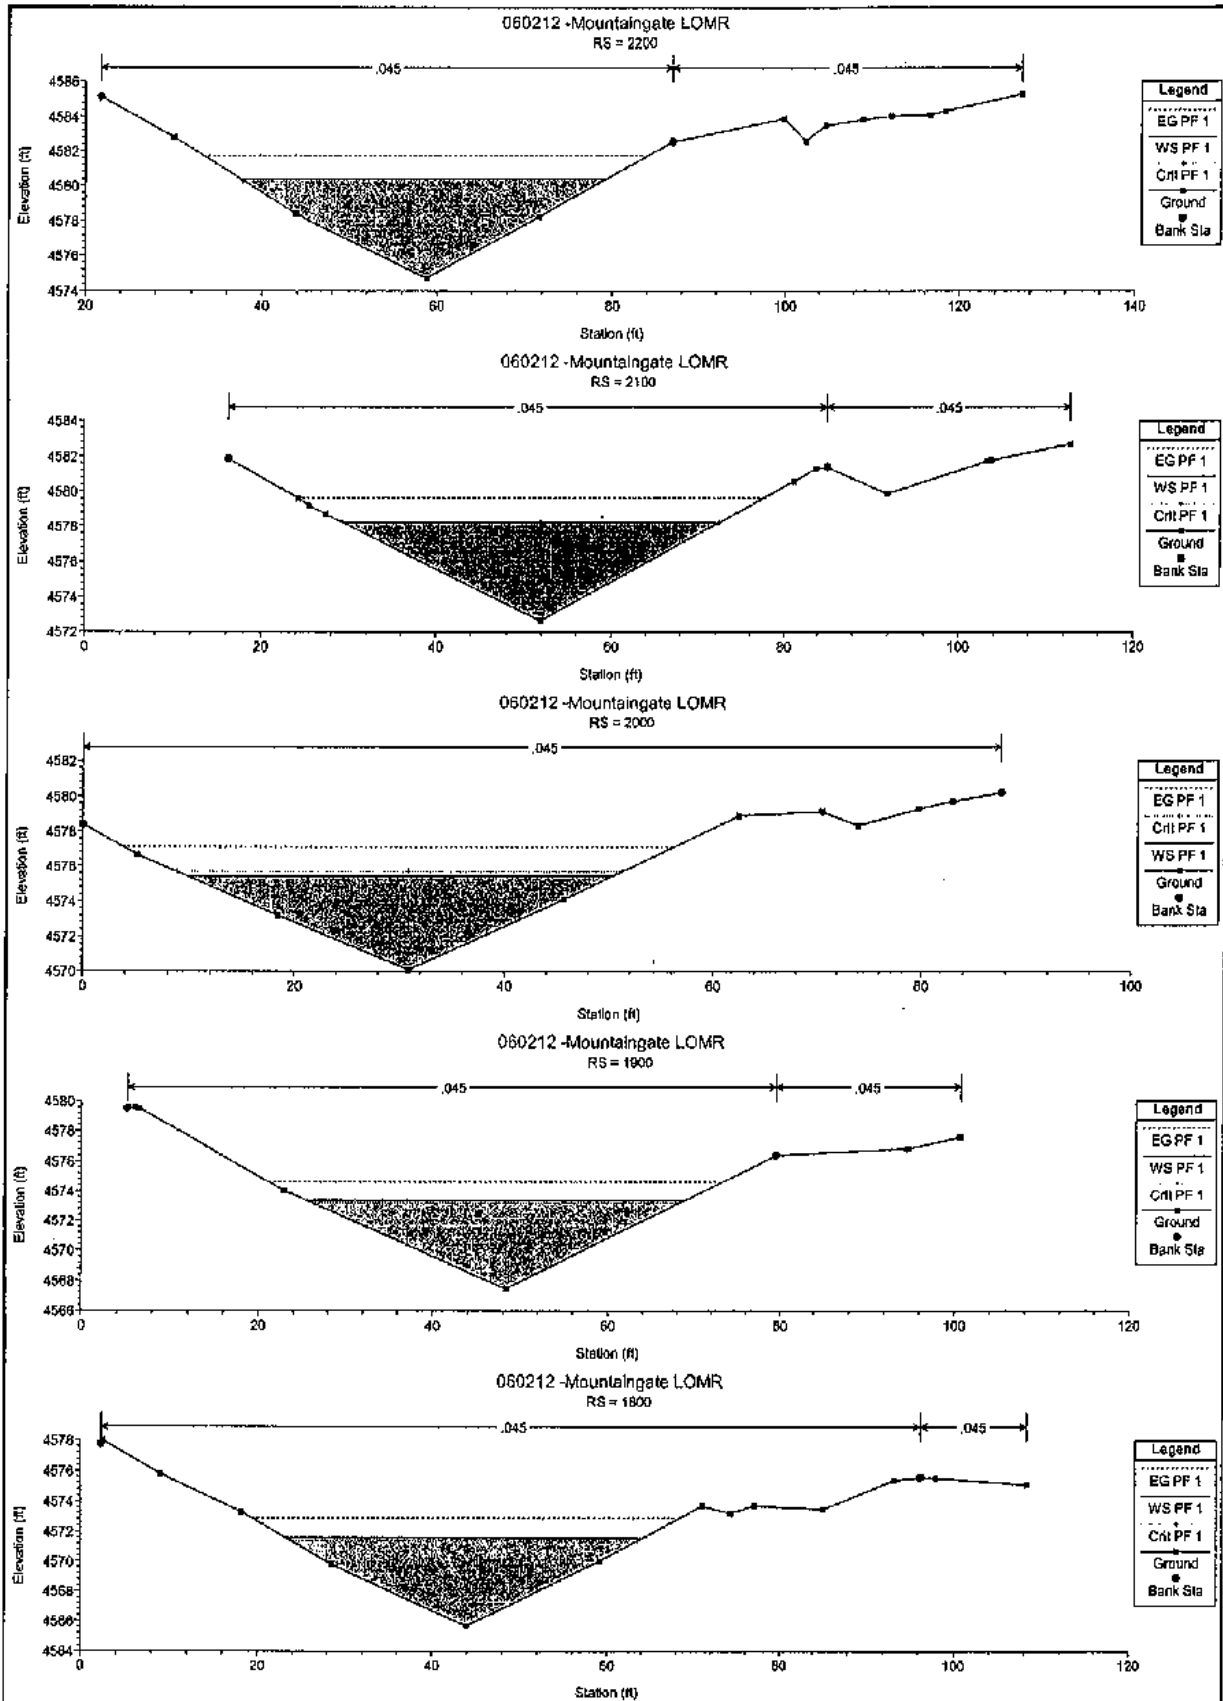

060212 -Mountaingate LOMR
RS = 1700


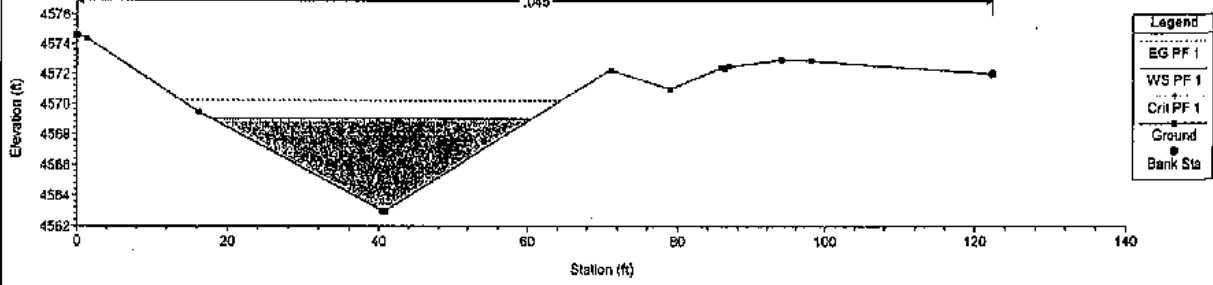


- Legend
- EG PF 1
 - WS PF 1
 - Crit PF 1
 - Ground
 - Bank Sta

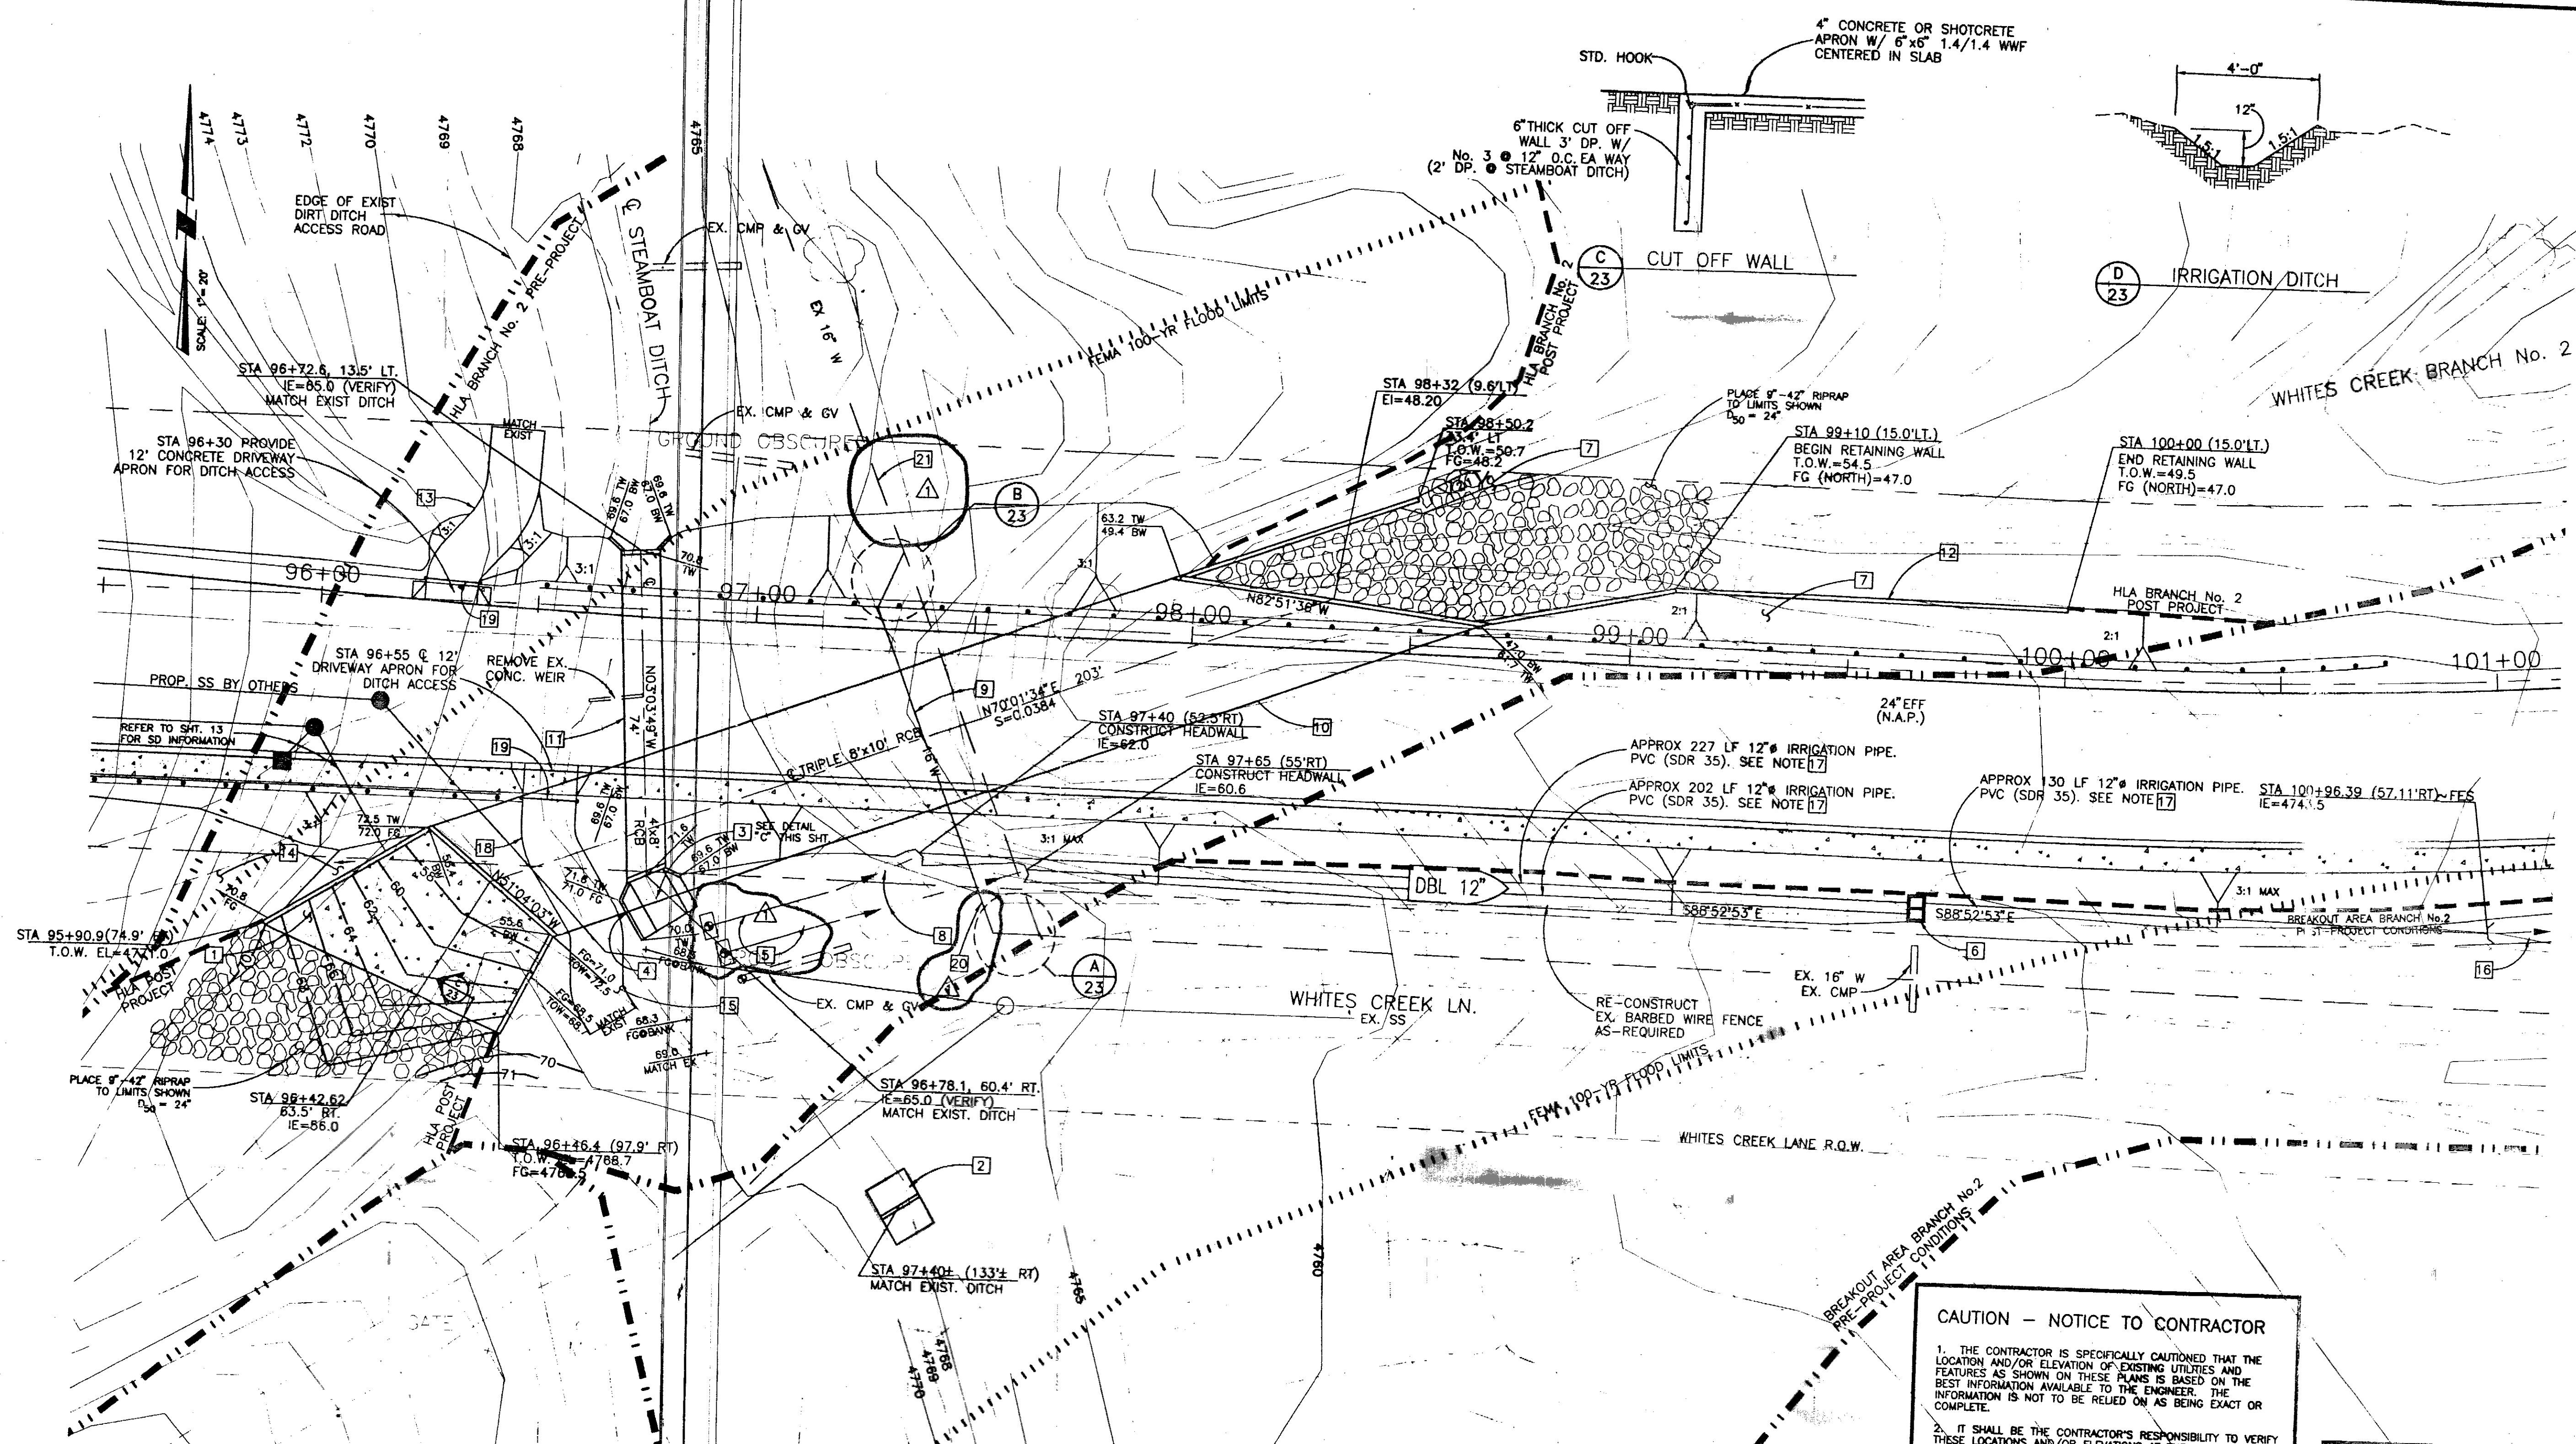

- CONSTRUCTION NOTES:**
1. CONST. CONCRETE APRON PER FG ELEVATIONS AS SHOWN. SEE DETAIL 'C' THIS SHEET.
 2. CONSTRUCT CONCRETE RECTANGULAR SHARP CRESTED WEIR AND SLAB BELDOW WITH EMBEDDED GALVANIZED STEEL PLATES TO FORM EDGE OF WEIR AND SLOTS FOR REMOVABLE 2x BOARDS. WEIR MARKINGS, CONSTRUCTION AND GEOMETRY PER STEAMBOAT DITCH AUTHORITIES DIRECTION.
 3. SHOTCRETE DITCH APPROX. 12 LF BEYOND HEADWALL. USE 6x6-1.4x1.4 WWF REINFORCING. CONSTRUCT 2" DEEP CUT OFF WALL AT END OF SHOTCRETE APRON. SEE DETAIL 'C' THIS SHEET, SIMILAR.
 4. CONSTRUCT APPROXIMATELY 15 LF 3' HIGH CONCRETE RETAINING WALL. SEE DETAIL 'E' SHEET 26 FOR STRUCTURAL REQUIREMENTS.
 5. THE CONTRACTOR IS TO RECONSTRUCT IRRIGATION DIVERSION BOXES IN THE NEW LOCATION IDENTICAL TO THE EXISTING STRUCTURES. CONTRACTOR SHALL COORDINATE ALL IRRIGATION RELATED WORK WITH THE STEAMBOAT DITCH COMPANY.
 6. CONSTRUCT 4x6' CONCRETE JUNCTION BOX WITH 12" GATE VALVE AS SHOWN IN DETAIL 'E'. USE 6" CONCRETE WALLS AND SLAB WITH #4 @ 12" O.C. EA WAY. DOVEL INTO WALLS. FIELD LOCATE TO ALIGN WITH EXISTING DITCH AND CROSSING UNDER WHITES CREEK LANE.
 7. 2:1 SLOPES TO RECEIVE 6"-12" RIPRAP.
 8. CONSTRUCT IRRIGATION DITCH FROM CMP TO HEADWALL. SEE DETAIL 'D' THIS SHEET.
 9. RELOCATE EXISTING 16" D.I.P. UNDER PROPOSED RCB AS SHOWN. USE A MINIMUM 10" HORIZONTAL OFFSET FROM EXISTING LINE. USE 45° ELBOWS WITH THRUST BLOCKS AS NECESSARY TO ACHIEVE GRADE BELDOW RCB. MINIMUM COVER IS 42". COORDINATE CONSTRUCTION WITH WASHOE COUNTY UTILITY DIVISION.
 10. CONSTRUCT (3) 8"x10" C.I.P. OR PRE-CAST RCB WITH WING WALL AND END CONFIGURATIONS AS SHOWN. CONTRACTOR SHALL PROVIDE SHOP DRAWINGS, DESIGN LOADING OF HS20-44. ALLOWABLE SOIL BEARING PRESSURE OF 3000 PSF.
 11. CONSTRUCT 4x8' C.I.P. OR PRE-CAST RCB WITH WINGWALL CONFIGURATIONS AS SHOWN. CONTRACTOR SHALL PROVIDE SHOP DRAWINGS, DESIGN LOADING OF HS20-44. ALLOWABLE SOIL BEARING PRESSURE OF 3000 PSF.

- CONSTRUCTION NOTES:**
12. CONST. CONCRETE RETAINING WALL TO LIMITS SHOWN. SEE DETAIL 'E' SHEET 26.
 13. CONSTRUCT APPROXIMATELY 40 LF 12" MINIMUM WIDE GRAVEL DITCH ACCESS RAMP. 12% MAX. GRADE.
 14. FILL AGAINST WING WALL AS SHOWN TO ACHIEVE POSITIVE DRAINAGE AROUND WING WALL. REFER TO SHEET 13 FOR ADDITIONAL DIRECTION REGARDING DITCH DAYLIGHT LOCATION AND GRADING IN THIS AREA.
 15. GRADE AREA TO FINISH GRADE ELEVATIONS AS SHOWN.
 16. CONSTRUCT APPROXIMATELY 20 LF IRRIGATION DITCH FROM FES TO EXISTING IRRIGATION DITCH. SEE DETAIL 'D' THIS SHEET. REFER TO SHEET 14 FOR ADDITIONAL INFORMATION.
 17. FLATTEN ROADWAY FILL SLOPE SO AS TO ACHIEVE A MINIMUM OF 1" OF COVER OVER 12" PVC IRRIGATION PIPES.
 18. CONSTRUCT APPROXIMATELY 110 LF 12" MINIMUM WIDE GRAVEL DITCH ACCESS. AS SHOWN. 12% MAX. GRADE.
 19. CONSTRUCT 6' HIGH CHAIN LINK FENCE DOUBLE SWING GATE BEHIND APRON.
 20. PRIOR TO THE RELOCATION OF THE EXISTING 16" WATER LINE, THE CONTRACTOR IS REQUIRED TO SUBMIT A WATER DISINFECTION PLAN TO WASHOE COUNTY FOR APPROVAL.
 21. THE CONTRACTOR IS REQUIRED TO DETERMINE TO VERIFY THE LOCATION & ELEVATION OF THE EXISTING 16" WATER LINE & INFORM THE ENGINEER OF HIS/HER FINDINGS PRIOR TO ANY CONSTRUCTION.

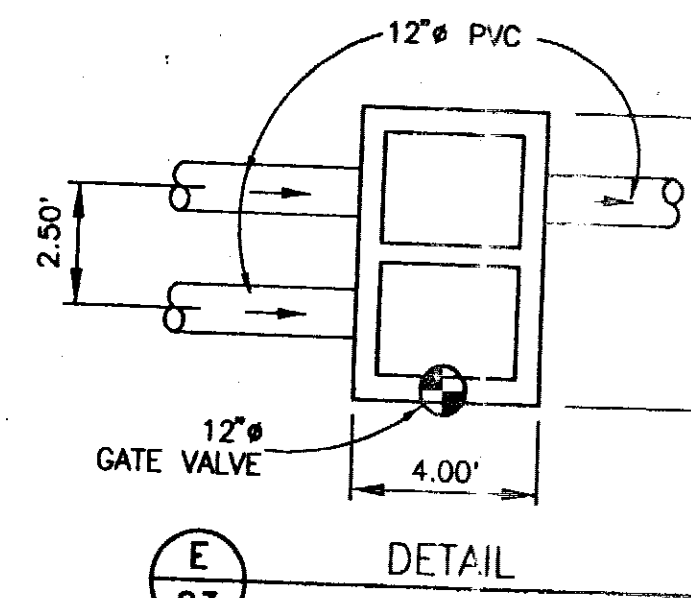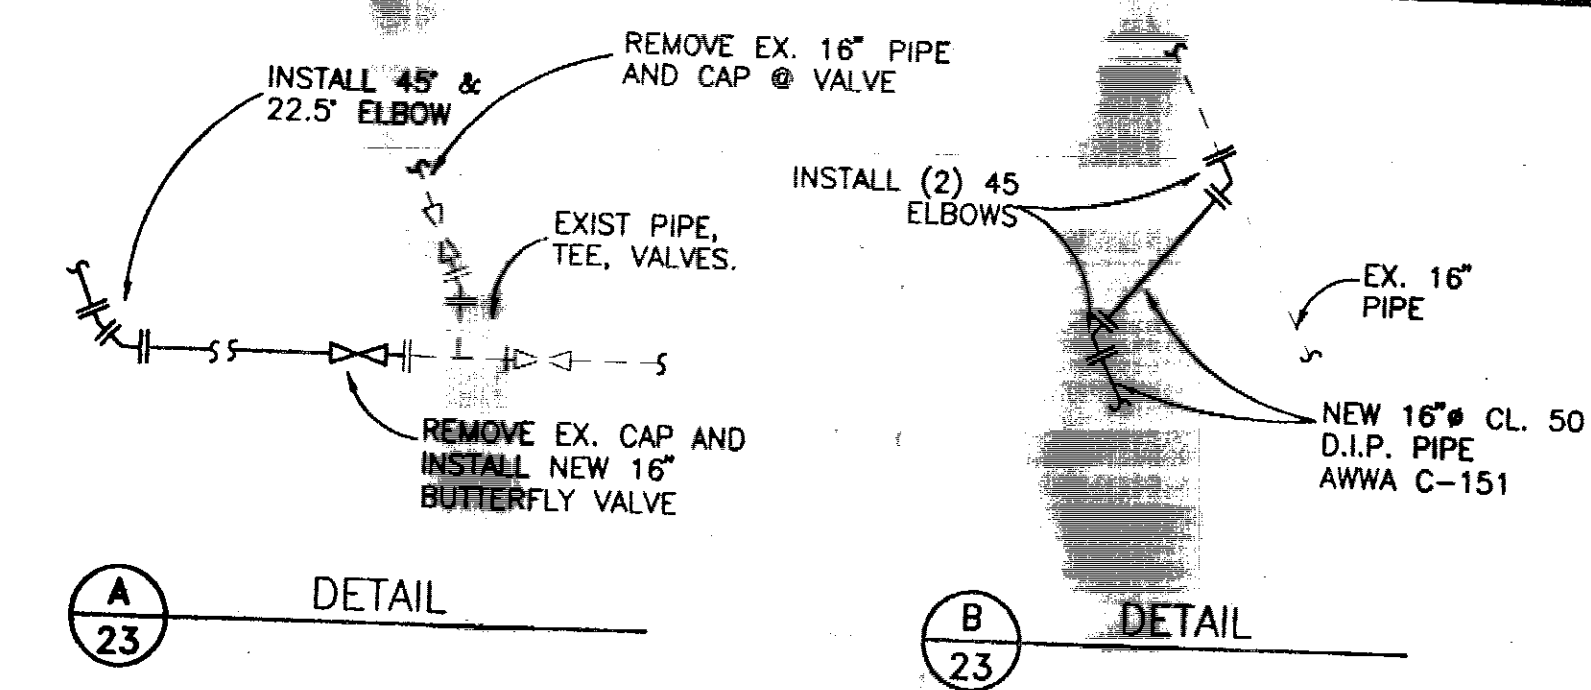

CAUTION - NOTICE TO CONTRACTOR


1. THE CONTRACTOR IS SPECIFICALLY CAUTIONED THAT THE LOCATION AND/OR ELEVATION OF EXISTING UTILITIES AND FEATURES AS SHOWN ON THESE PLANS IS BASED ON THE BEST INFORMATION AVAILABLE TO THE ENGINEER. THE INFORMATION IS NOT TO BE RELIED ON AS BEING EXACT OR COMPLETE.
2. IT SHALL BE THE CONTRACTOR'S RESPONSIBILITY TO VERIFY THESE LOCATIONS AND/OR ELEVATIONS AT THE PROPOSED POINTS OF CONNECTION AND IN AREAS OF POSSIBLE CONFLICT PRIOR TO BEGINNING CONSTRUCTION. SHOULD THE CONTRACTOR FIND ANY DISCREPANCIES BETWEEN THE INFORMATION EXISTING IN THE FIELD AND THE INFORMATION SHOWN ON THESE DRAWINGS, HE SHALL NOTIFY THE ENGINEER BEFORE PROCEEDING WITH CONSTRUCTION.
3. IT SHALL BE THE RESPONSIBILITY OF THE CONTRACTOR TO REMOVE OR RELOCATE ALL EXISTING UTILITIES AND FEATURES WHICH CONFLICT WITH THE PROPOSED IMPROVEMENTS SHOWN ON THESE PLANS. CONTRACTOR SHALL OBTAIN APPROVALS FROM THE GOVERNING AGENCIES, THE ENGINEER, AND THE UTILITY COMPANIES PRIOR TO SUCH REMOVAL AND/OR RELOCATION.

STATUS OF PLANS	
<input type="checkbox"/> PRELIMINARY	DATE: _____
<input type="checkbox"/> INITIAL SUBMITTAL	DATE: _____
<input type="checkbox"/> FINAL SUBMITTAL	DATE: _____
<input checked="" type="checkbox"/> APPROVED BY WASHOE CO. ENG.	DATE: 10/10/97
<input checked="" type="checkbox"/> APPROVED BY WASHOE CO. UTIL.	DATE: 10/10/97
<input type="checkbox"/> LATEST REVISION	DATE: _____
APPROVED: YES <input type="checkbox"/> NO <input type="checkbox"/>	

RECORD DRAWINGS

THESE DRAWINGS ARE BASED ON INFORMATION PROVIDED TO CFA BY THE CONTRACTOR AND HAVE BEEN ADJUSTED TO REFLECT THESE CHANGES. THE ENGINEER IS ONLY DOING SO FOR DESIGN PURPOSES. THERE ARE NO WARRANTIES OR GUARANTEES AS TO THE ACCURACY OF THE AS-BUILT INFORMATION.

04-05-99

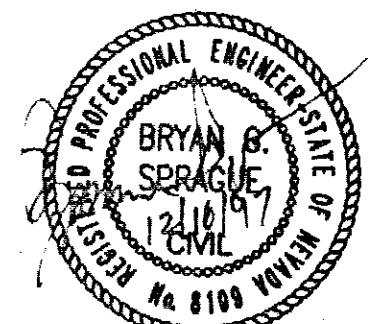

ARROWCREEK SAD # 23

PLAN 3-8'x10' RCB

WASHOE COUNTY

DESIGNED BY: GS
 DRAWN BY: GS
 CHECKED BY: BCS
 APPROVED BY: [Signature]

DATE SURVEYED: 4/10/97
 DATE: 10/10/97

R. E. NO. _____
 DATE _____
 MARK _____
 REVISIONS _____

INCLUDE (Items from Addendum #1 (10/22/97))

1100 CORPORATE BLVD., RENO, NV 89502 (702) 850-1150 FAX: (702) 850-1100

ENGINEERS LANDSCAPE ARCHITECTS SURVEYORS


cfa

FILE NO.: X:\PROJECTS\98-003.DWG\WC23.DWG


JOB NO. 98-03-27
 DATE 9/12/97
 SHEET 23 OF 29

VERTICAL: 1" = 4'

SCALE: 1" = 40'

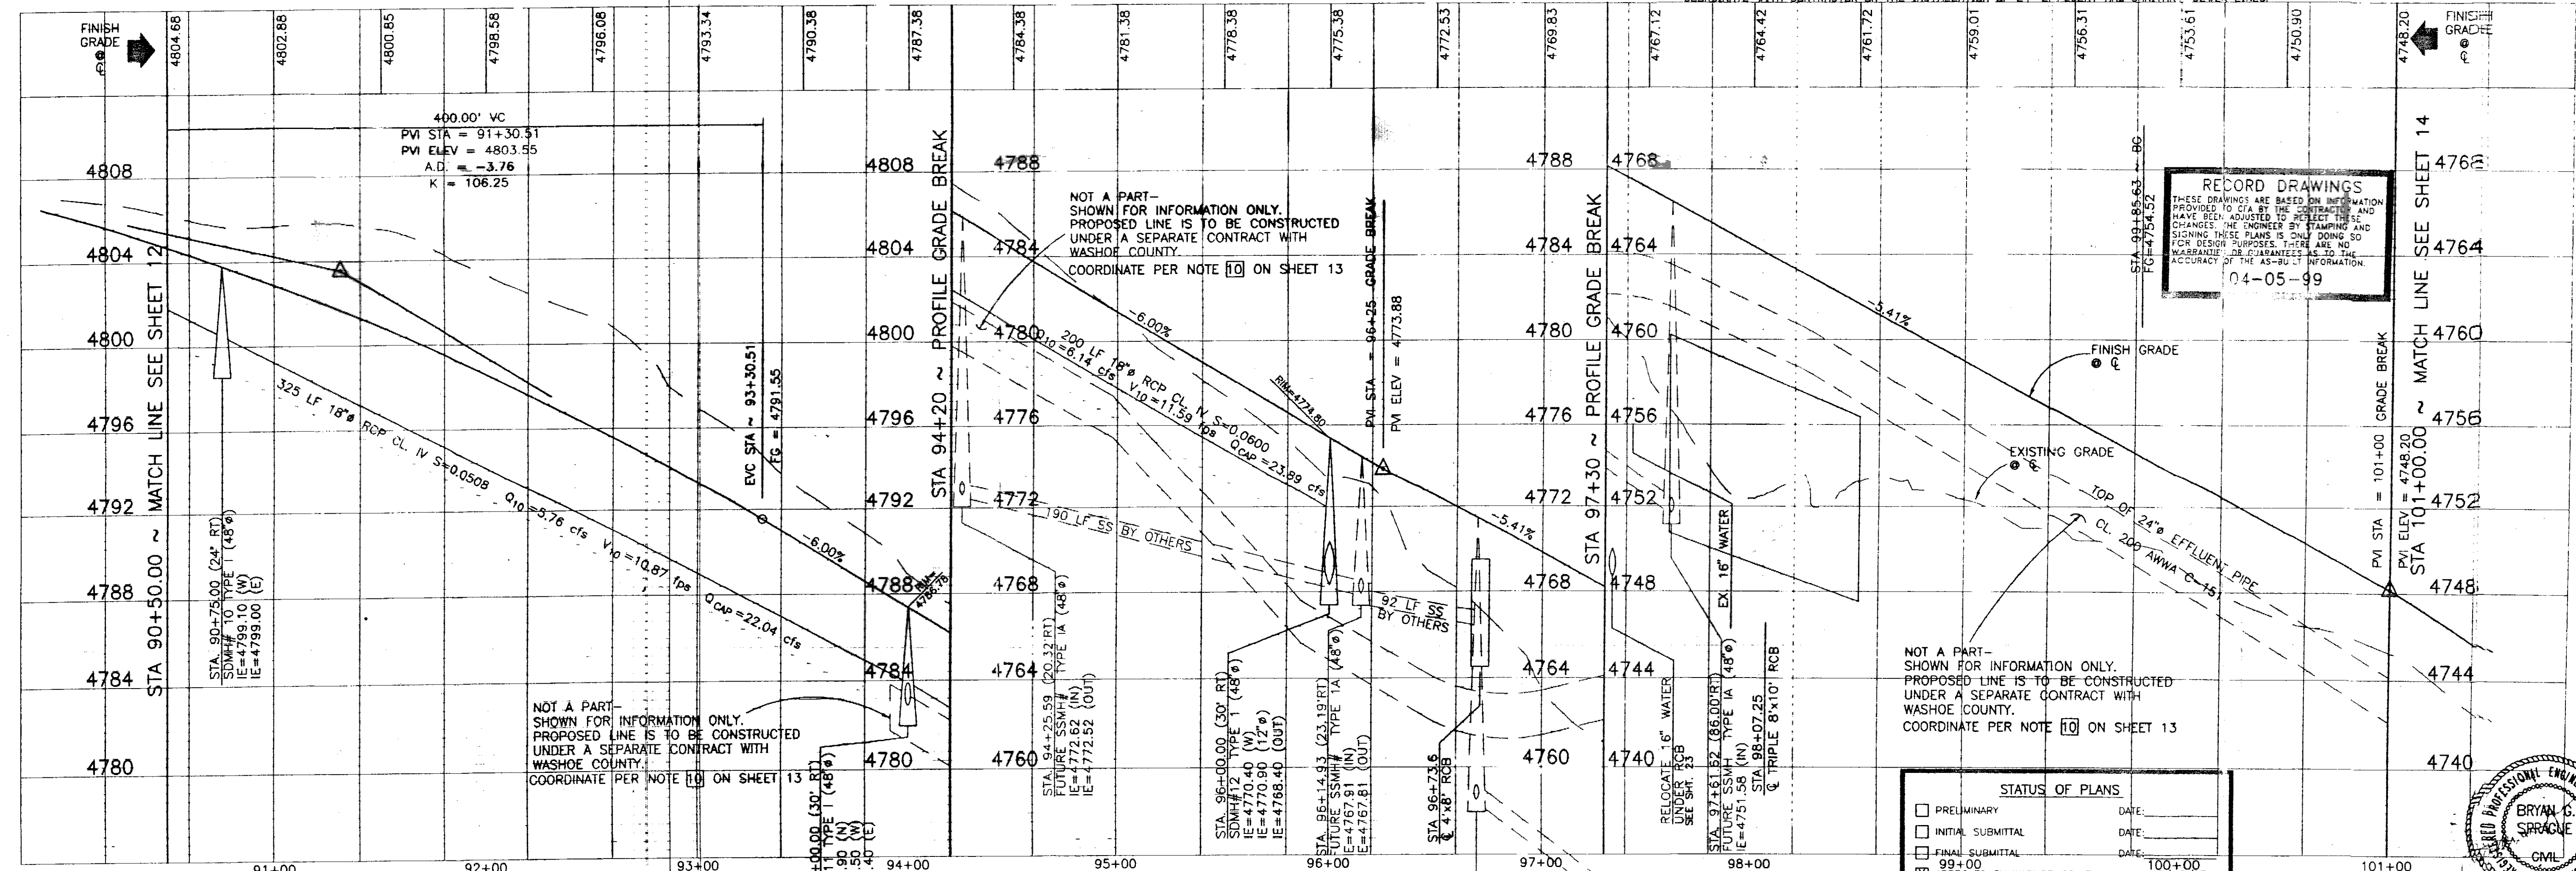

HORIZONTAL: 1" = 40'

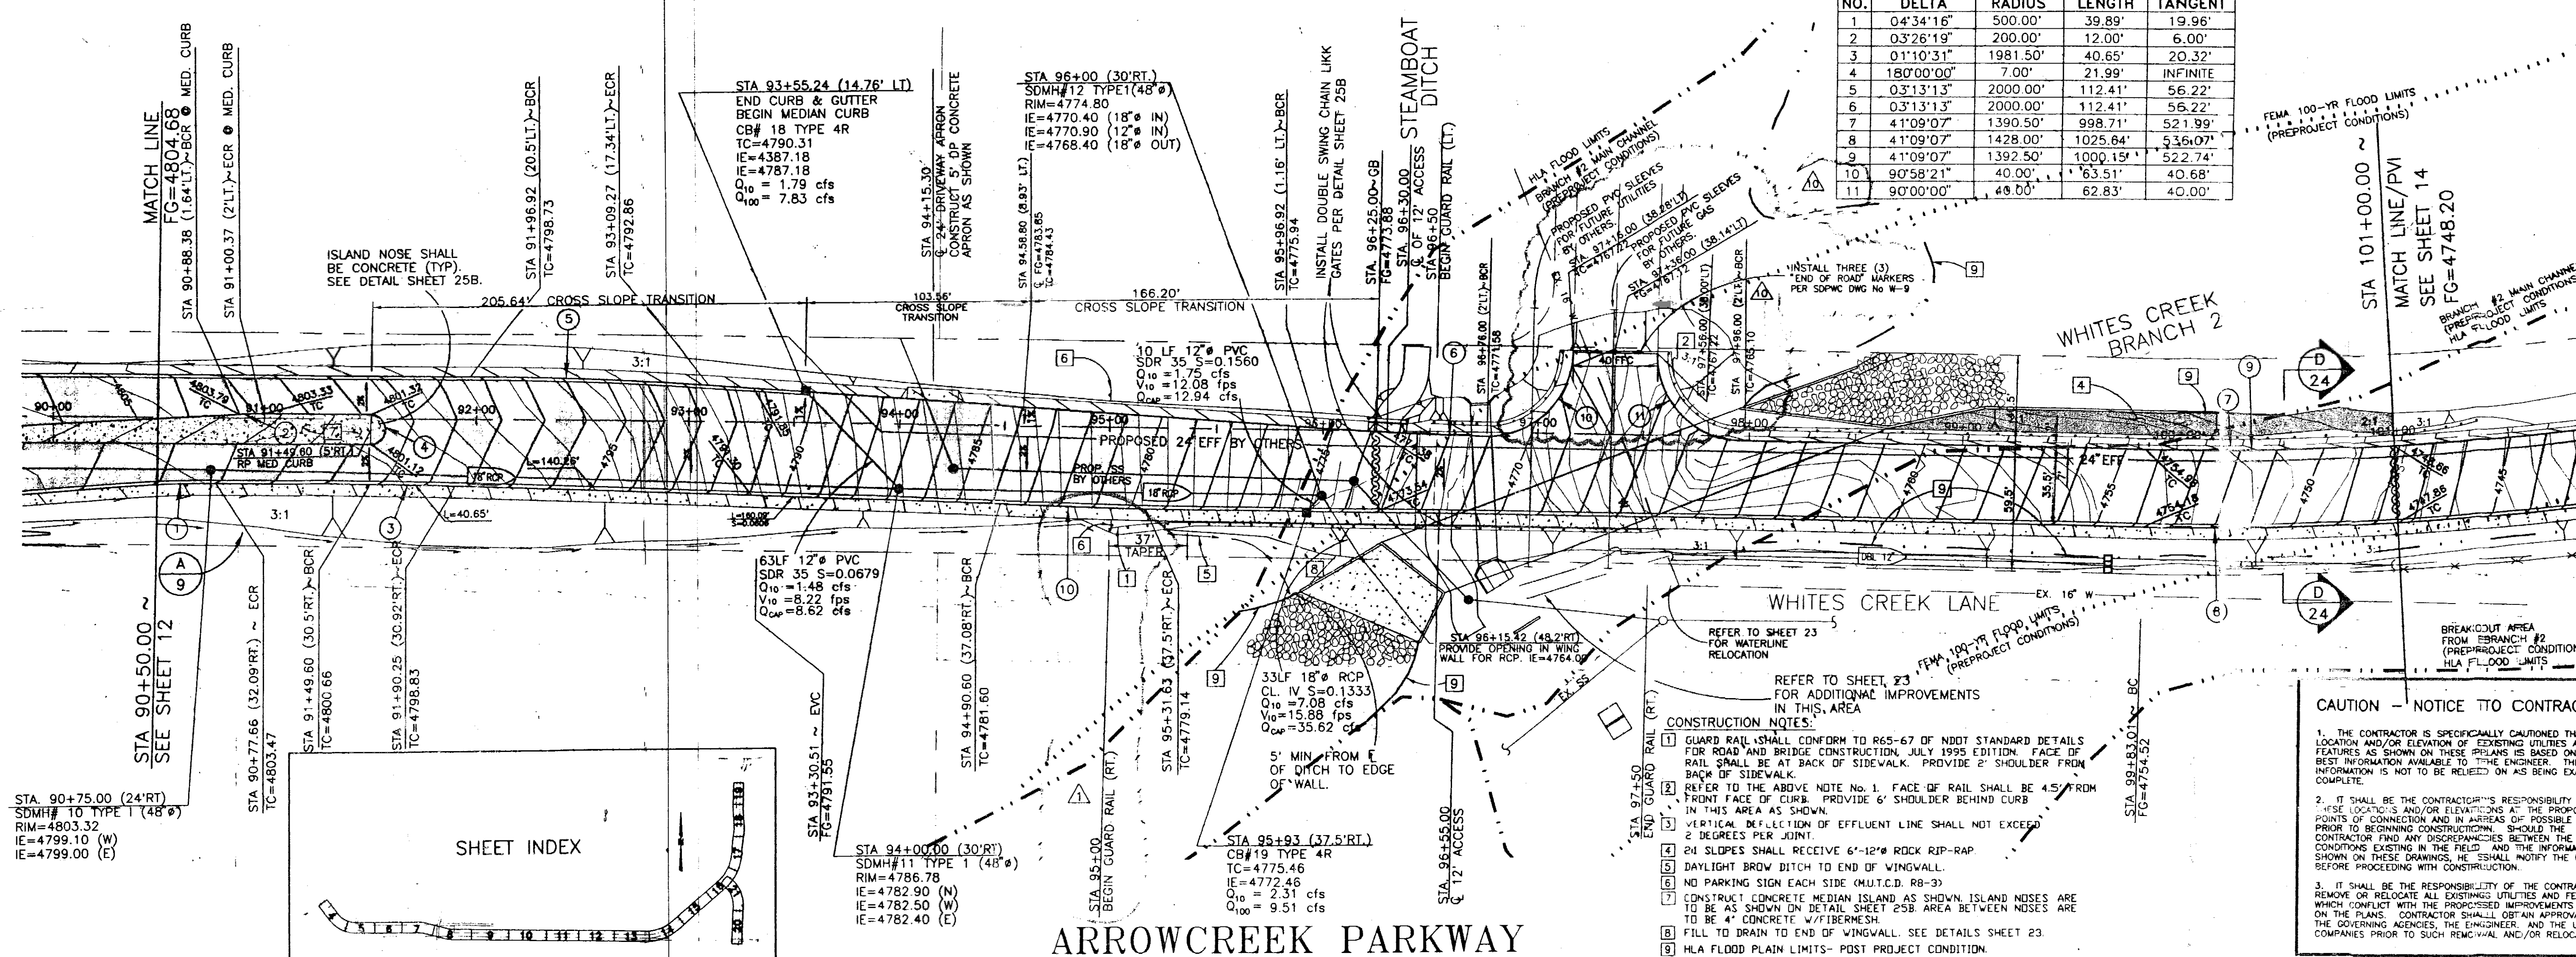

NO.	DELTA	CURVE RADIUS	LENGTH	TANGENT
1	0°34'16"	500.00'	39.89'	19.96'
2	0°32'19"	200.00'	12.00'	6.00'
3	0°1'10'31"	1981.50'	40.65'	20.32'
4	180°00'00"	7.00'	21.99'	INFINITE
5	0°3'13'13"	2000.00'	112.41'	56.22'
6	0°3'13'13"	2000.00'	112.41'	56.22'
7	41°09'07"	1390.50'	998.71'	521.99'
8	41°09'07"	1428.00'	1025.64'	536.07'
9	41°09'07"	1392.50'	1000.15'	522.74'
10	90°58'21"	40.00'	63.51'	40.68'
11	90°00'00"	40.00'	62.83'	40.00'

CAUTION - NOTICE TO CONTRACTOR

- THE CONTRACTOR IS SPECIFICALLY CAUTIONED THAT THE LOCATION AND/OR ELEVATION OF EXISTING UTILITIES AND FEATURES AS SHOWN ON THESE PLANS IS BASED ON THE BEST INFORMATION AVAILABLE TO THE ENGINEER. THE INFORMATION IS NOT TO BE RELIED ON AS BEING EXACT OR COMPLETE.
- IT SHALL BE THE CONTRACTOR'S RESPONSIBILITY TO VERIFY THESE LOCATIONS AND/OR ELEVATIONS AT THE PROPOSED POINTS OF CONNECTION AND IN AREAS OF POSSIBLE CONFLICT PRIOR TO BEGINNING CONSTRUCTION. SHOULD THE CONTRACTOR FIND ANY DISCREPANCIES BETWEEN THE CONDITIONS EXISTING IN THE FIELD AND THE INFORMATION SHOWN ON THESE DRAWINGS, HE SHALL NOTIFY THE ENGINEER BEFORE PROCEEDING WITH CONSTRUCTION.
- IT SHALL BE THE RESPONSIBILITY OF THE CONTRACTOR TO REMOVE OR RELOCATE ALL EXISTING UTILITIES AND FEATURES WHICH CONFLICT WITH THE PROPOSED IMPROVEMENTS SHOWN ON THESE PLANS. CONTRACTOR SHALL OBTAIN APPROVALS FROM THE GOVERNING AGENCIES, THE ENGINEER, AND THE UTILITY COMPANIES PRIOR TO SUCH REMOVAL AND/OR RELOCATION.

- CONSTRUCTION NOTES:**
- GUARD RAIL SHALL CONFORM TO R65-67 OF NDDOT STANDARD DETAILS FOR ROAD AND BRIDGE CONSTRUCTION, JULY 1995 EDITION. FACE OF RAIL SHALL BE AT BACK OF SIDEWALK. PROVIDE 2' SHOULDER FROM BACK OF SIDEWALK.
 - REFER TO THE ABOVE NOTE NO. 1. FACE OF RAIL SHALL BE 4.5' FROM FRONT FACE OF CURB. PROVIDE 6' SHOULDER BEHIND CURB IN THIS AREA AS SHOWN.
 - VERTICAL DEFLECTION OF EFFLUENT LINE SHALL NOT EXCEED 2 DEGREES PER JOINT.
 - 24" SLOPES SHALL RECEIVE 6'-12" ROCK RIP-RAP.
 - DAYLIGHT BROW DITCH TO END OF WINGWALL.
 - NO PARKING SIGN EACH SIDE (MUT.C.D. R8-3)
 - CONSTRUCT CONCRETE MEDIAN ISLAND AS SHOWN. ISLAND NOSES ARE TO BE AS SHOWN ON DETAIL SHEET 25B. AREA BETWEEN NOSES ARE TO BE 4" CONCRETE W/BERNESH.
 - FILL TO DRAIN TO END OF WINGWALL. SEE DETAILS SHEET 23.
 - HLA FLOOD PLAIN LIMITS - POST PROJECT CONDITION.
 - ALLOW THE CONTRACTOR FOR THE INSTALLATION OF THE EFFLUENT AND SEWER LINES TIME TO PLACE THE PIPES ONCE SUBGRADE HAS BEEN ESTABLISHED. COORDINATE WITH CONTRACTOR ON THE INSTALLATION OF 24" EFFLUENT AND SANITARY SEWER LINES.

RECORD DRAWINGS
 THESE DRAWINGS ARE BASED ON INFORMATION PROVIDED TO CFA BY THE CONTRACTOR. ANY CHANGES, INCLUDING ADJUSTMENTS TO THE PLANS, SHALL BE MADE BY THE CONTRACTOR. THE CONTRACTOR SHALL BE RESPONSIBLE FOR THE ACCURACY OF THE AS-BUILT INFORMATION.
 04-05-99

STATUS OF PLANS

<input type="checkbox"/> PRELIMINARY	DATE:
<input type="checkbox"/> INITIAL SUBMITTAL	DATE:
<input type="checkbox"/> FINAL SUBMITTAL	DATE:
<input checked="" type="checkbox"/> 99+00	DATE: 10/10/97
<input checked="" type="checkbox"/> APPROVED BY WASHOE CO. ENG.	DATE: 10/10/97
<input checked="" type="checkbox"/> APPROVED BY WASHOE CO. UTIL.	DATE: 10/10/97
<input type="checkbox"/> LATEST REVISION	DATE:
APPROVED: YES <input type="checkbox"/> NO <input type="checkbox"/>	DATE:

BENCH MARK:
 THE MONUMENT IS A NEVADA HIGHWAY SURVEY DISC. SET IN A CONCRETE POST WHICH PROJECTS 2 INCHES ABOVE THE GROUND AT STATION WA-D029-1-115. ELEVATION = 4596.57'

ARROWCREEK SAD # 23
PLAN & PROFILE
 ARROWCREEK PARKWAY


DESIGNED BY: CS DATE: 4/10/97
 DRAWN BY: GS/AC DATE: 4/10/97
 CHECKED BY: JNS DATE: 7/17/97
 APPROVED BY: DATE: 11/14/97

PLANNERS: ENGINEERS: ARCHITECTS: SURVEYORS: LANDSCAPE ARCHITECTS: (302) 790-1100 FAX: (302) 856-1100

NEVADA
 WASHOE COUNTY



JOB NO. 88-003.27
 DATE 9/12/97
 SHEET 13 OF 29

REVISIONS AS DIRECTED BY WC
 INCLUDES ITEMS FROM ADDENDUM #1 (10/22/97)





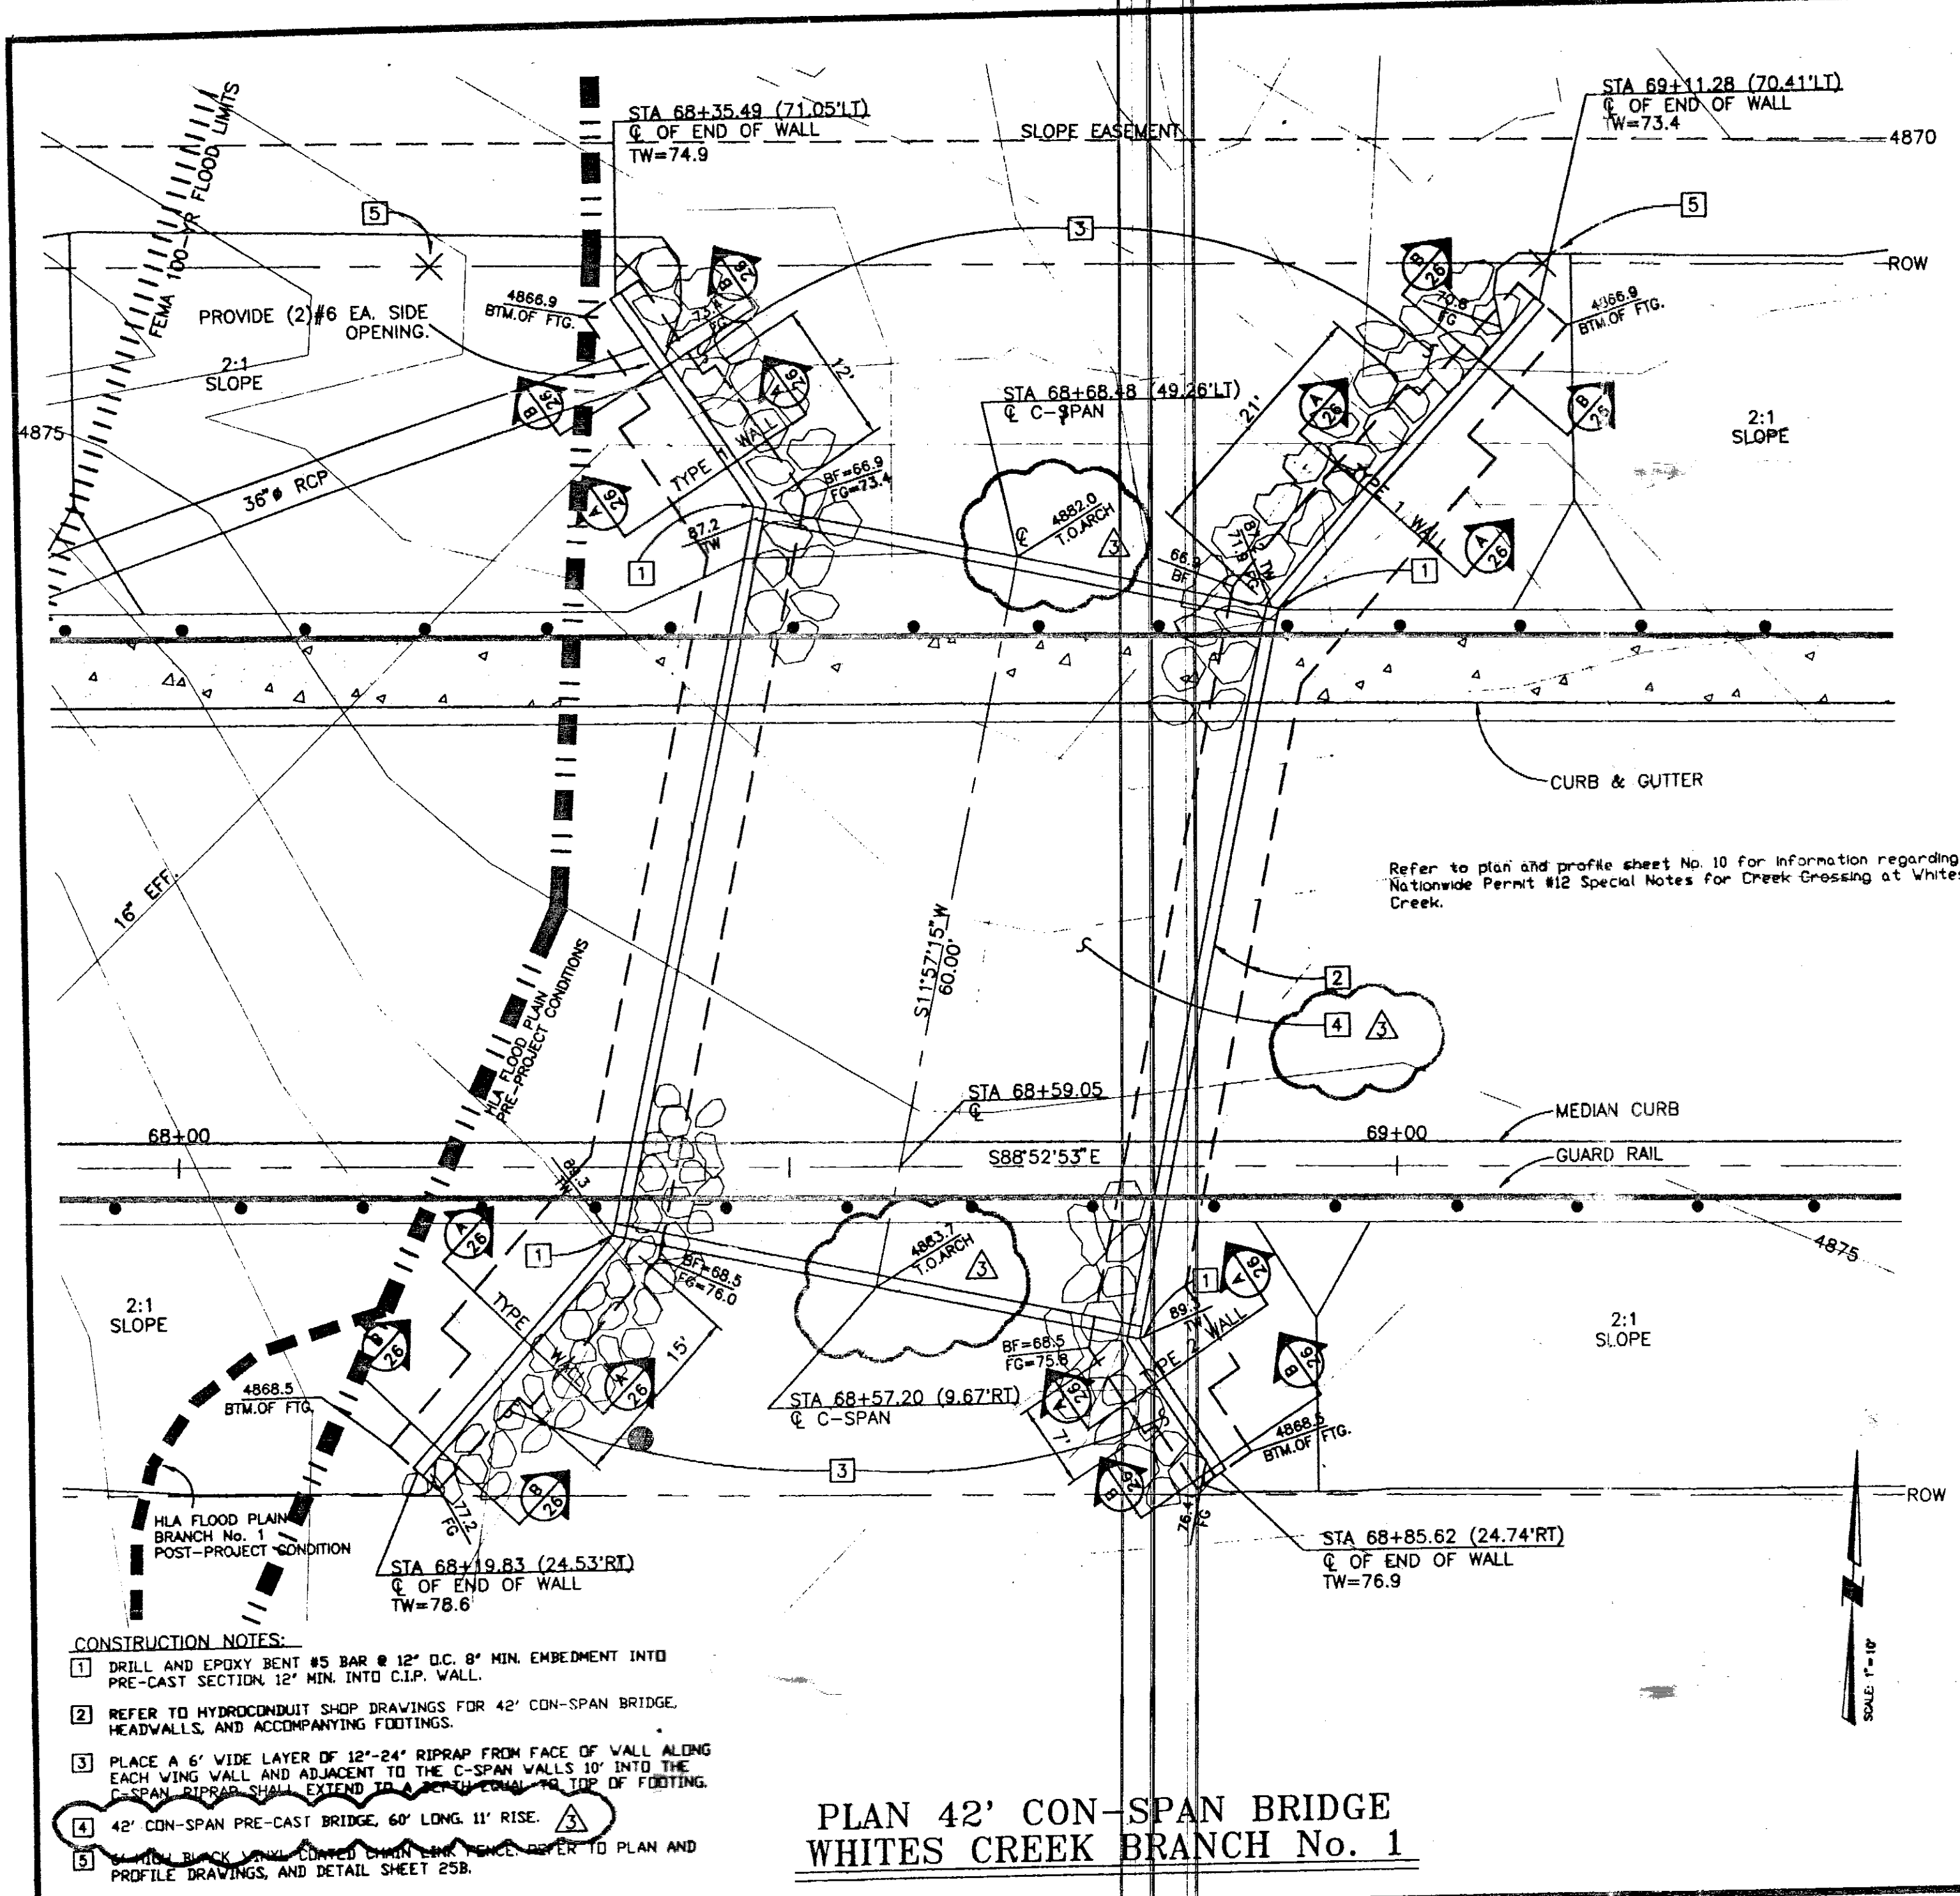


**PLAN 42' CON-SPAN BRIDGE
WHITES CREEK BRANCH No. 1**

- CONSTRUCTION NOTES:**
- 1 DRILL AND EPOXY BENT #5 BAR @ 12" O.C. 8" MIN. EMBEDMENT INTO PRE-CAST SECTION 12" MIN. INTO C.I.P. WALL.
 - 2 REFER TO HYDROCONDUIT SHOP DRAWINGS FOR 42' CON-SPAN BRIDGE, HEADWALLS, AND ACCOMPANYING FOOTINGS.
 - 3 PLACE A 6" WIDE LAYER OF 12"-24" RIPRAP FROM FACE OF WALL ALONG EACH WING WALL AND ADJACENT TO THE C-SPAN WALLS 10' INTO THE C-SPAN RIPRAP SHALL EXTEND TO THE TOP OF FOOTING.
 - 4 42' CON-SPAN PRE-CAST BRIDGE, 60' LONG, 11' RISE.
 - 5 ALL BACK FILL COVERED BY 18" MIN. COVER TO PLAN AND PROFILE DRAWINGS, AND DETAIL SHEET 25B.

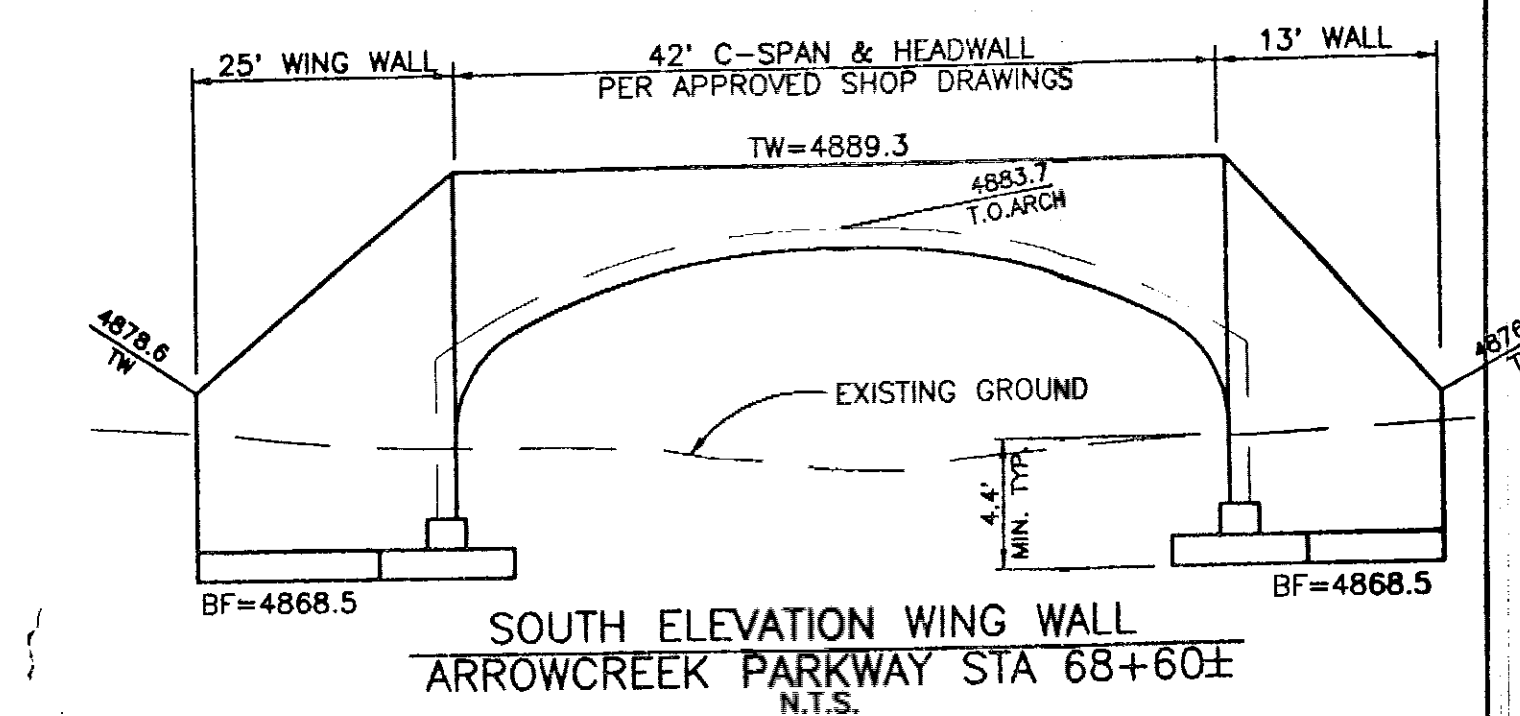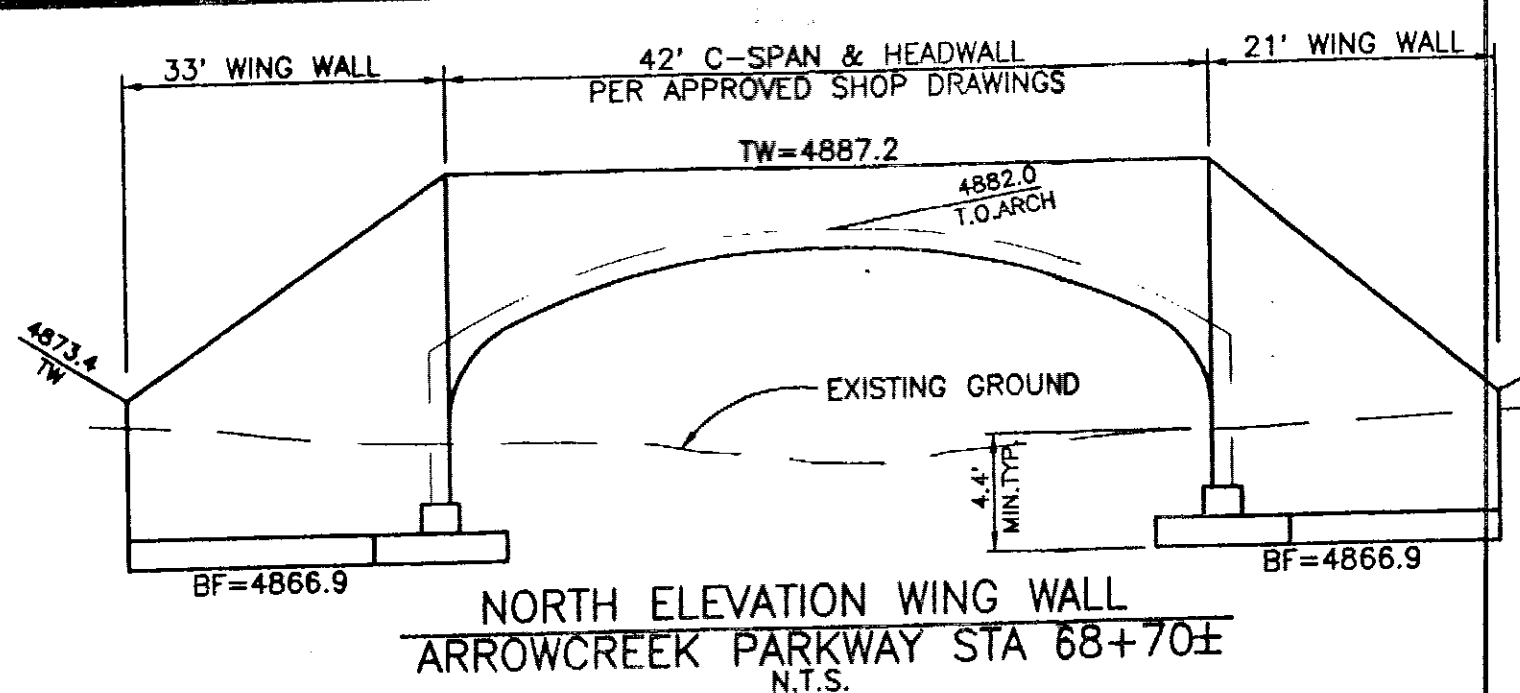

- NOTES:**
1. ALL EXCAVATION AND EMBANKMENT SHALL CONFORM TO GEOTECHNICAL INVESTIGATIONS AS REFERENCED IN THE GENERAL NOTES ON THE TITLE SHEET.
 2. C-SPAN SHALL BE PRE-CAST 42' SPAN, 11' RISE, 60'-0" LONG.
 3. REFER TO HYDRO-CONDUIT SHOP DRAWINGS (AS APPROVED BY ENGINEER) FOR C-SPAN, HEADWALL, AND ACCOMPANYING FOOTING.

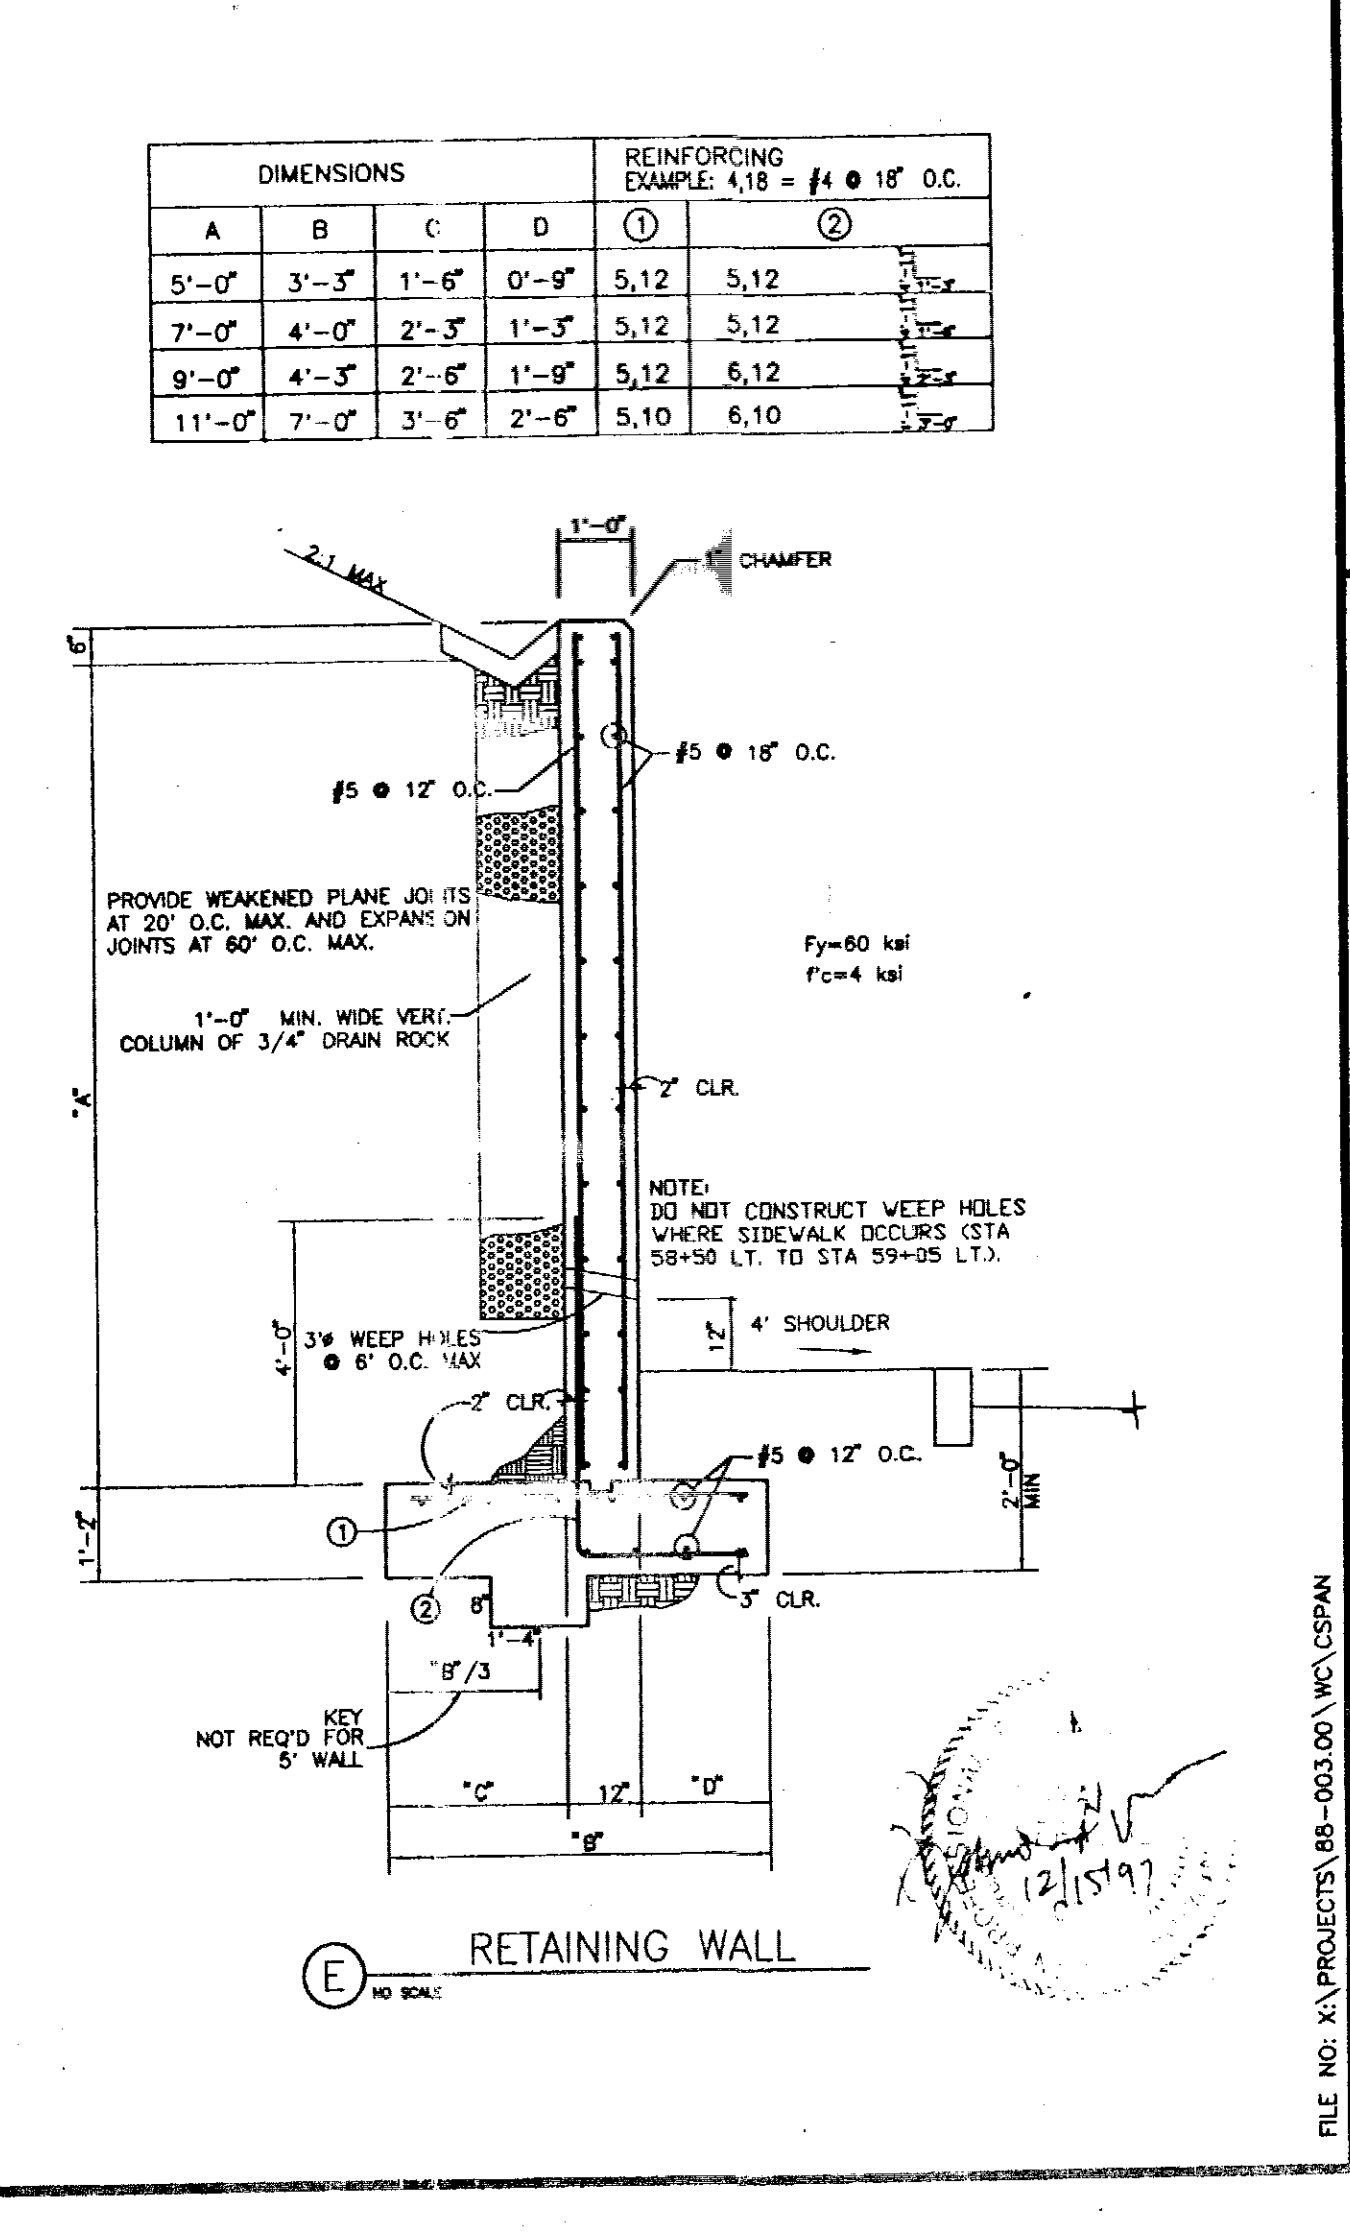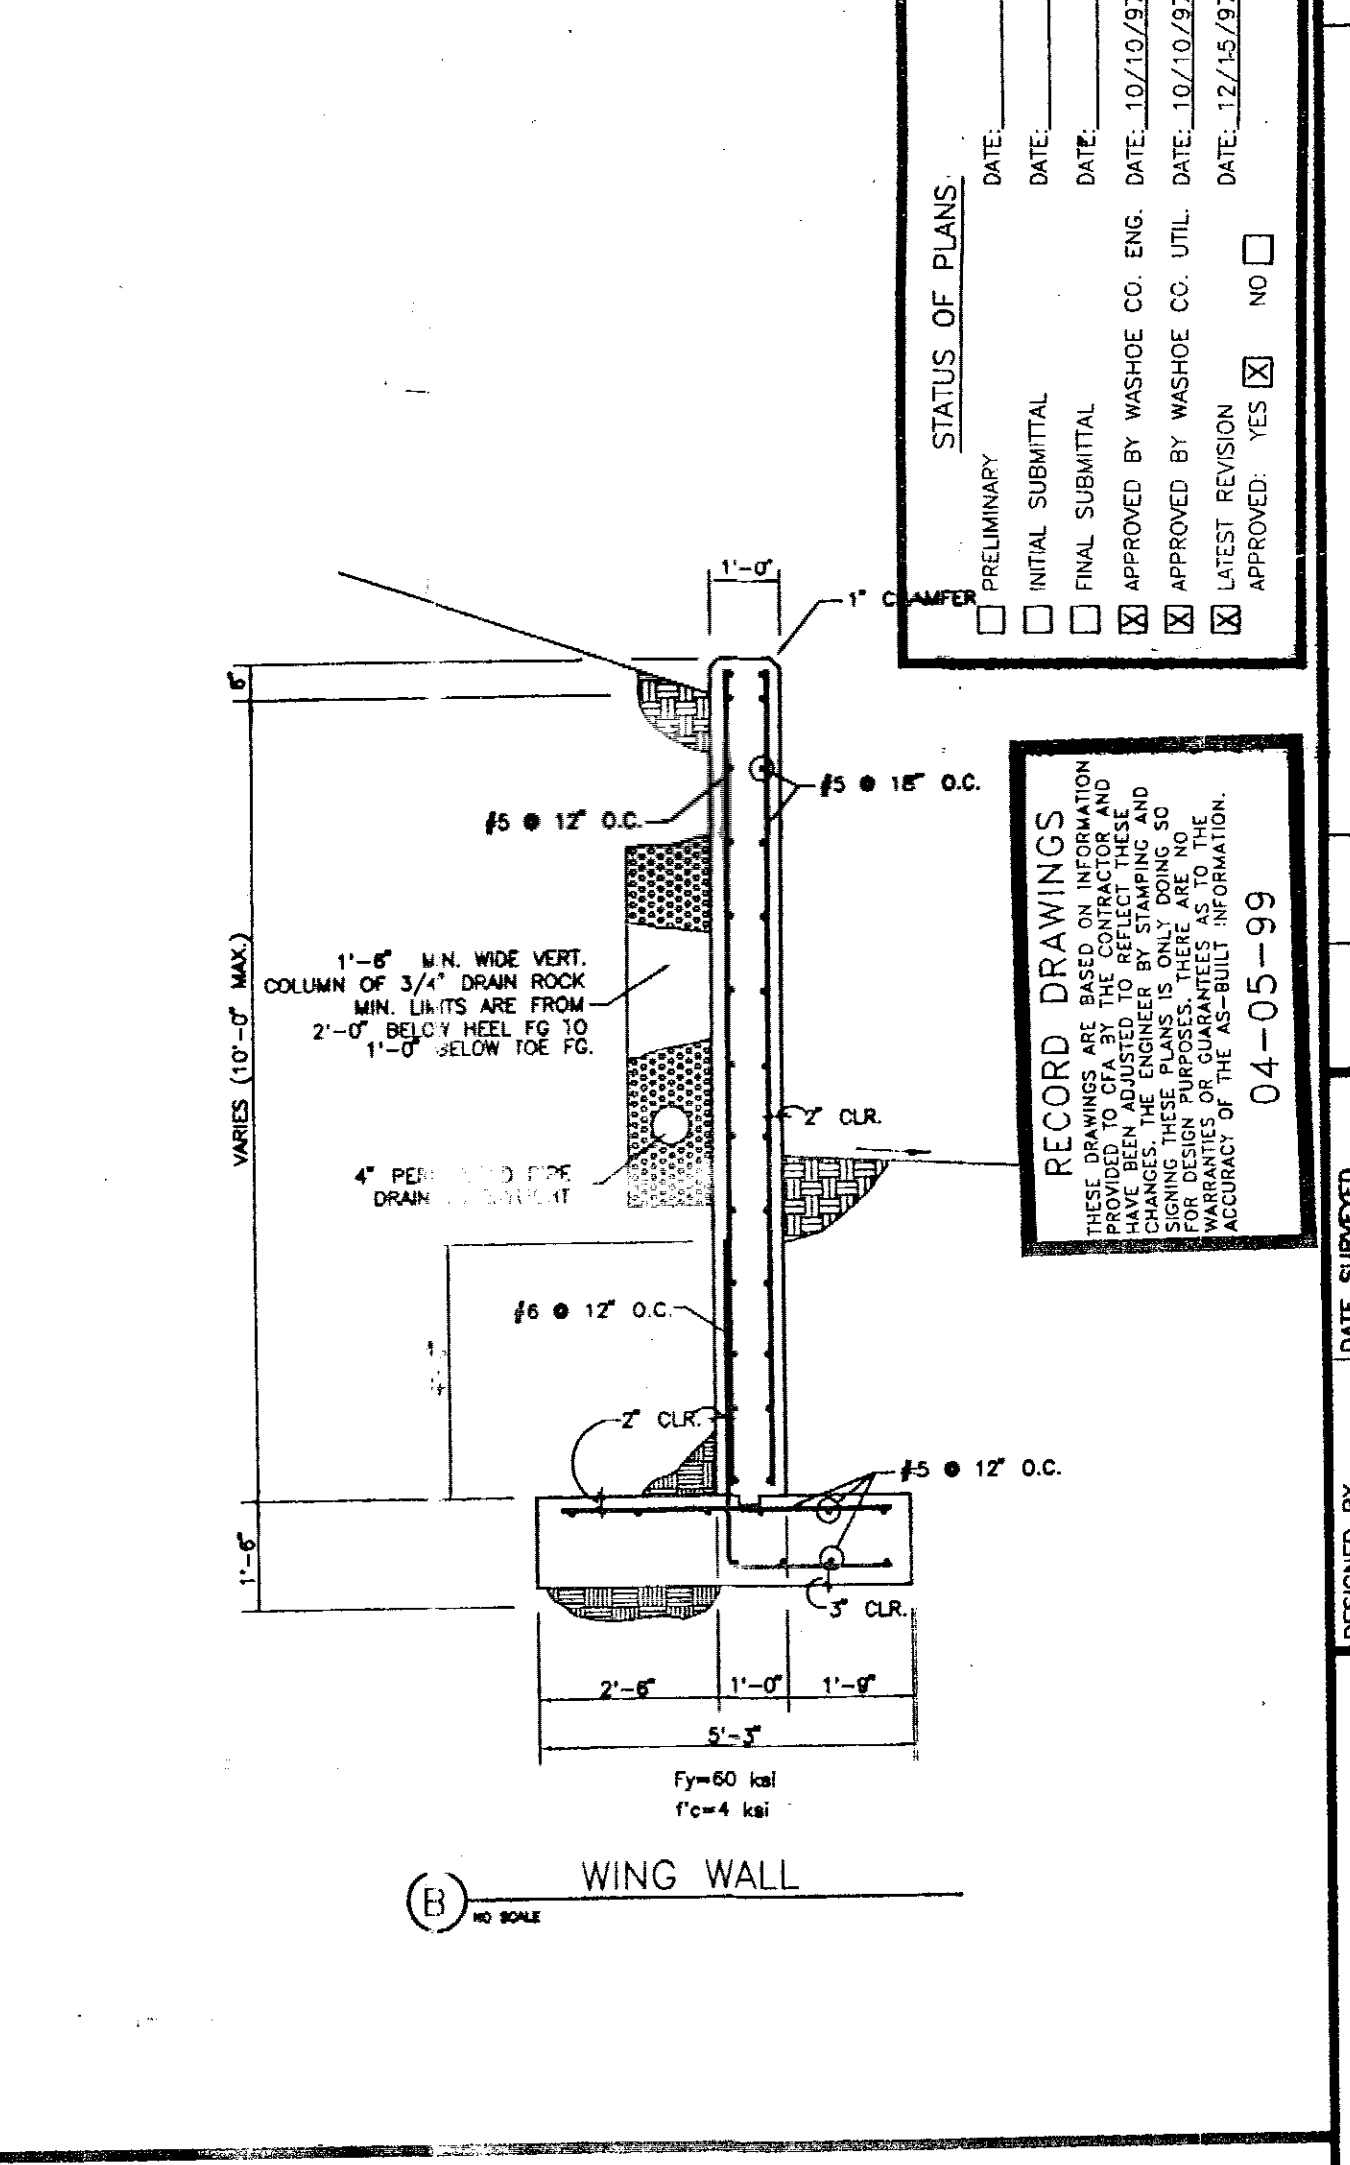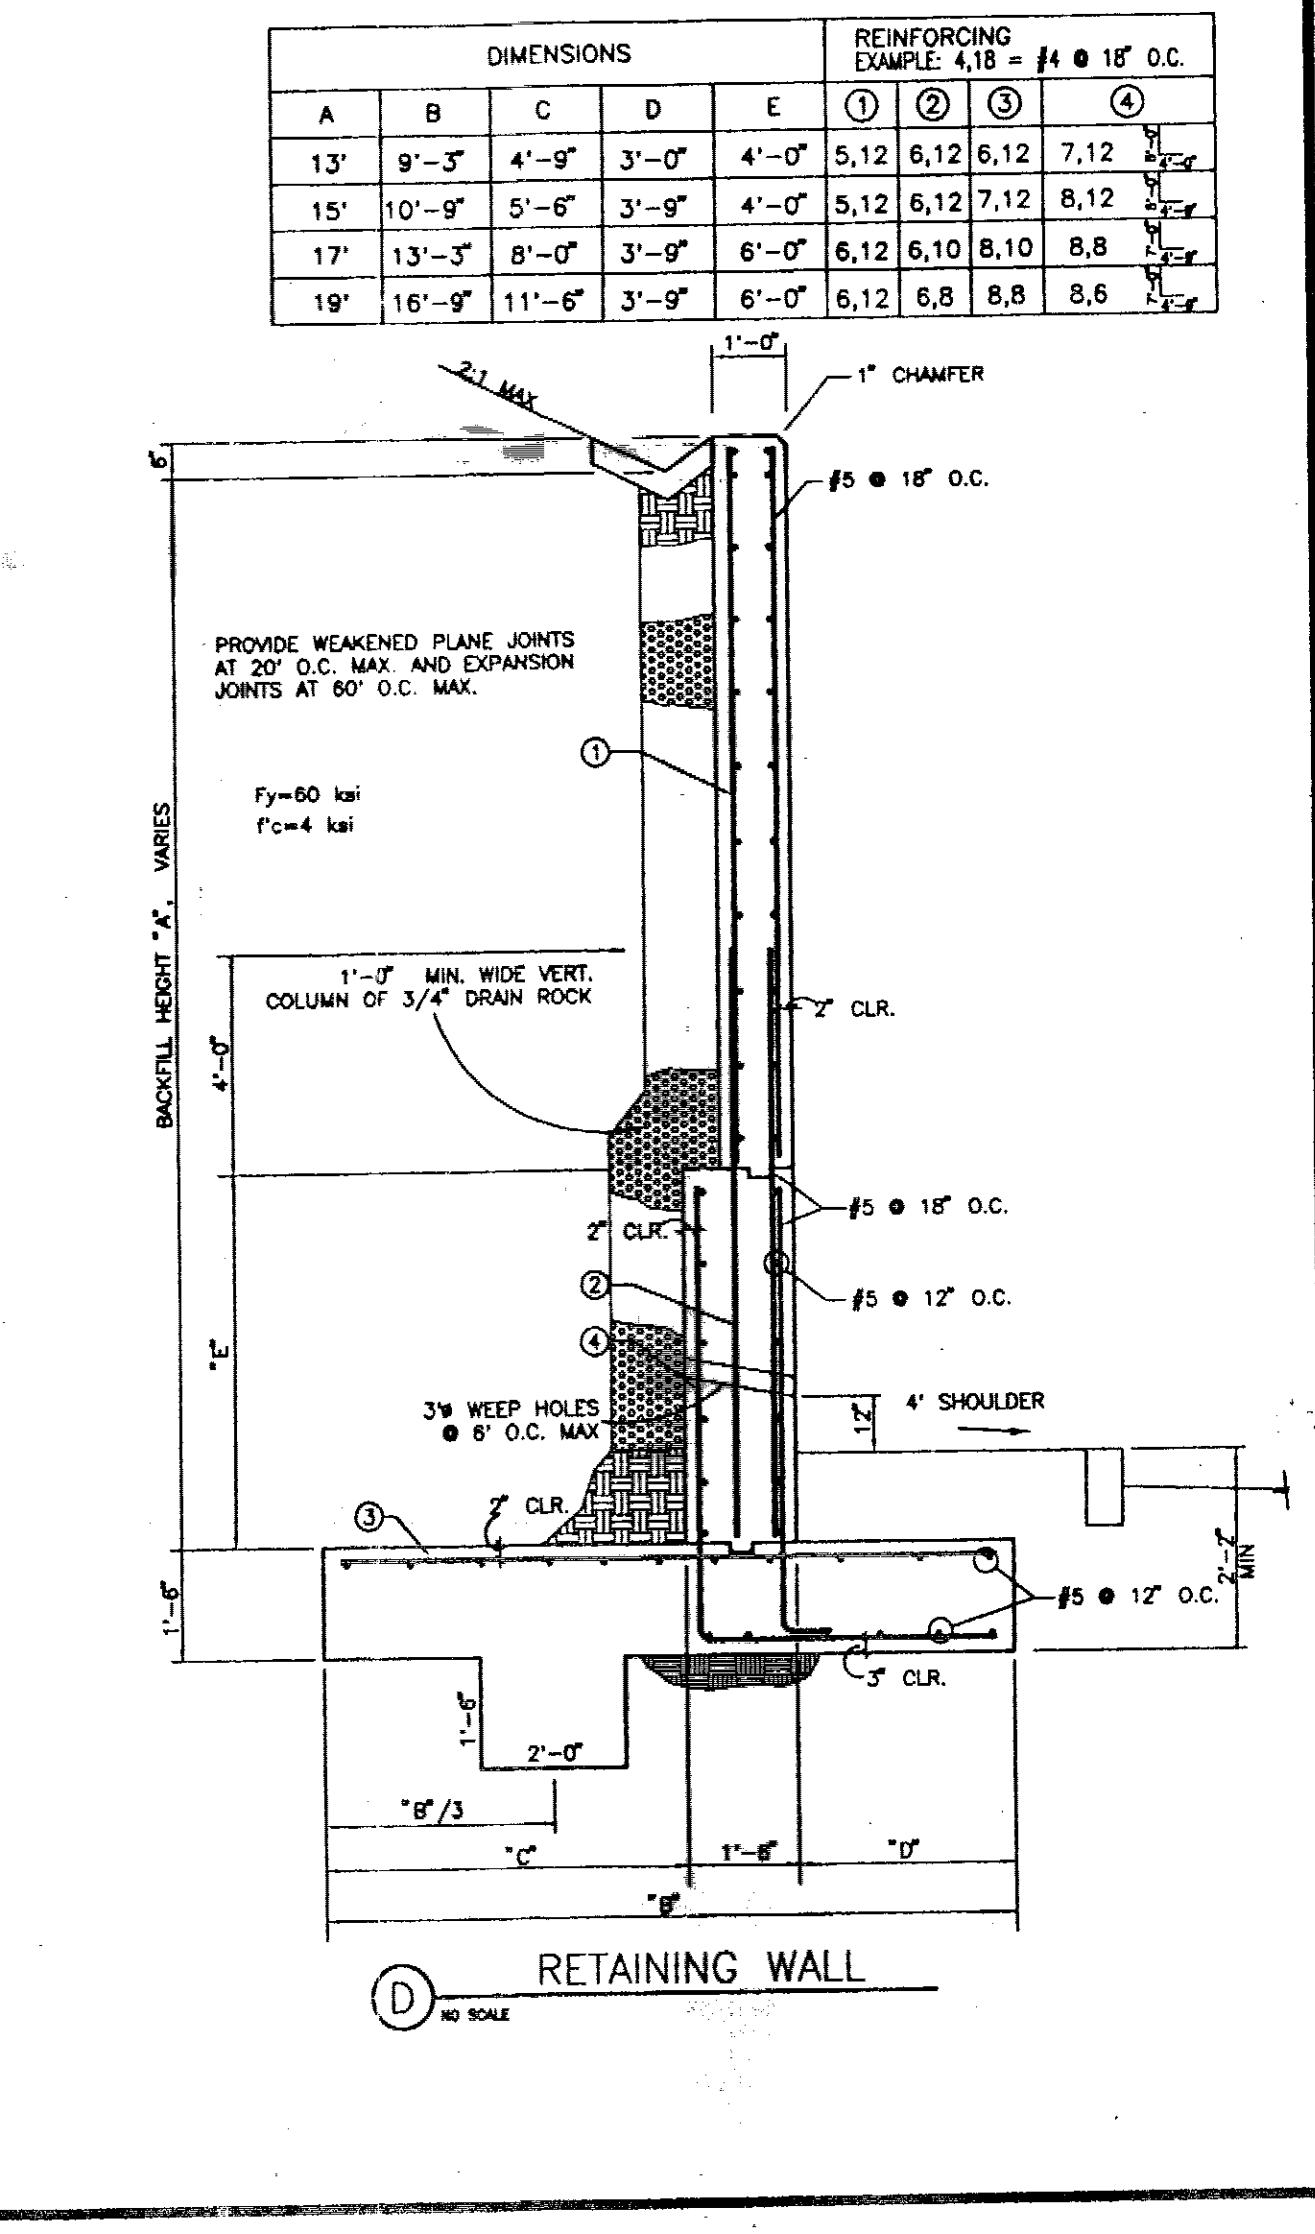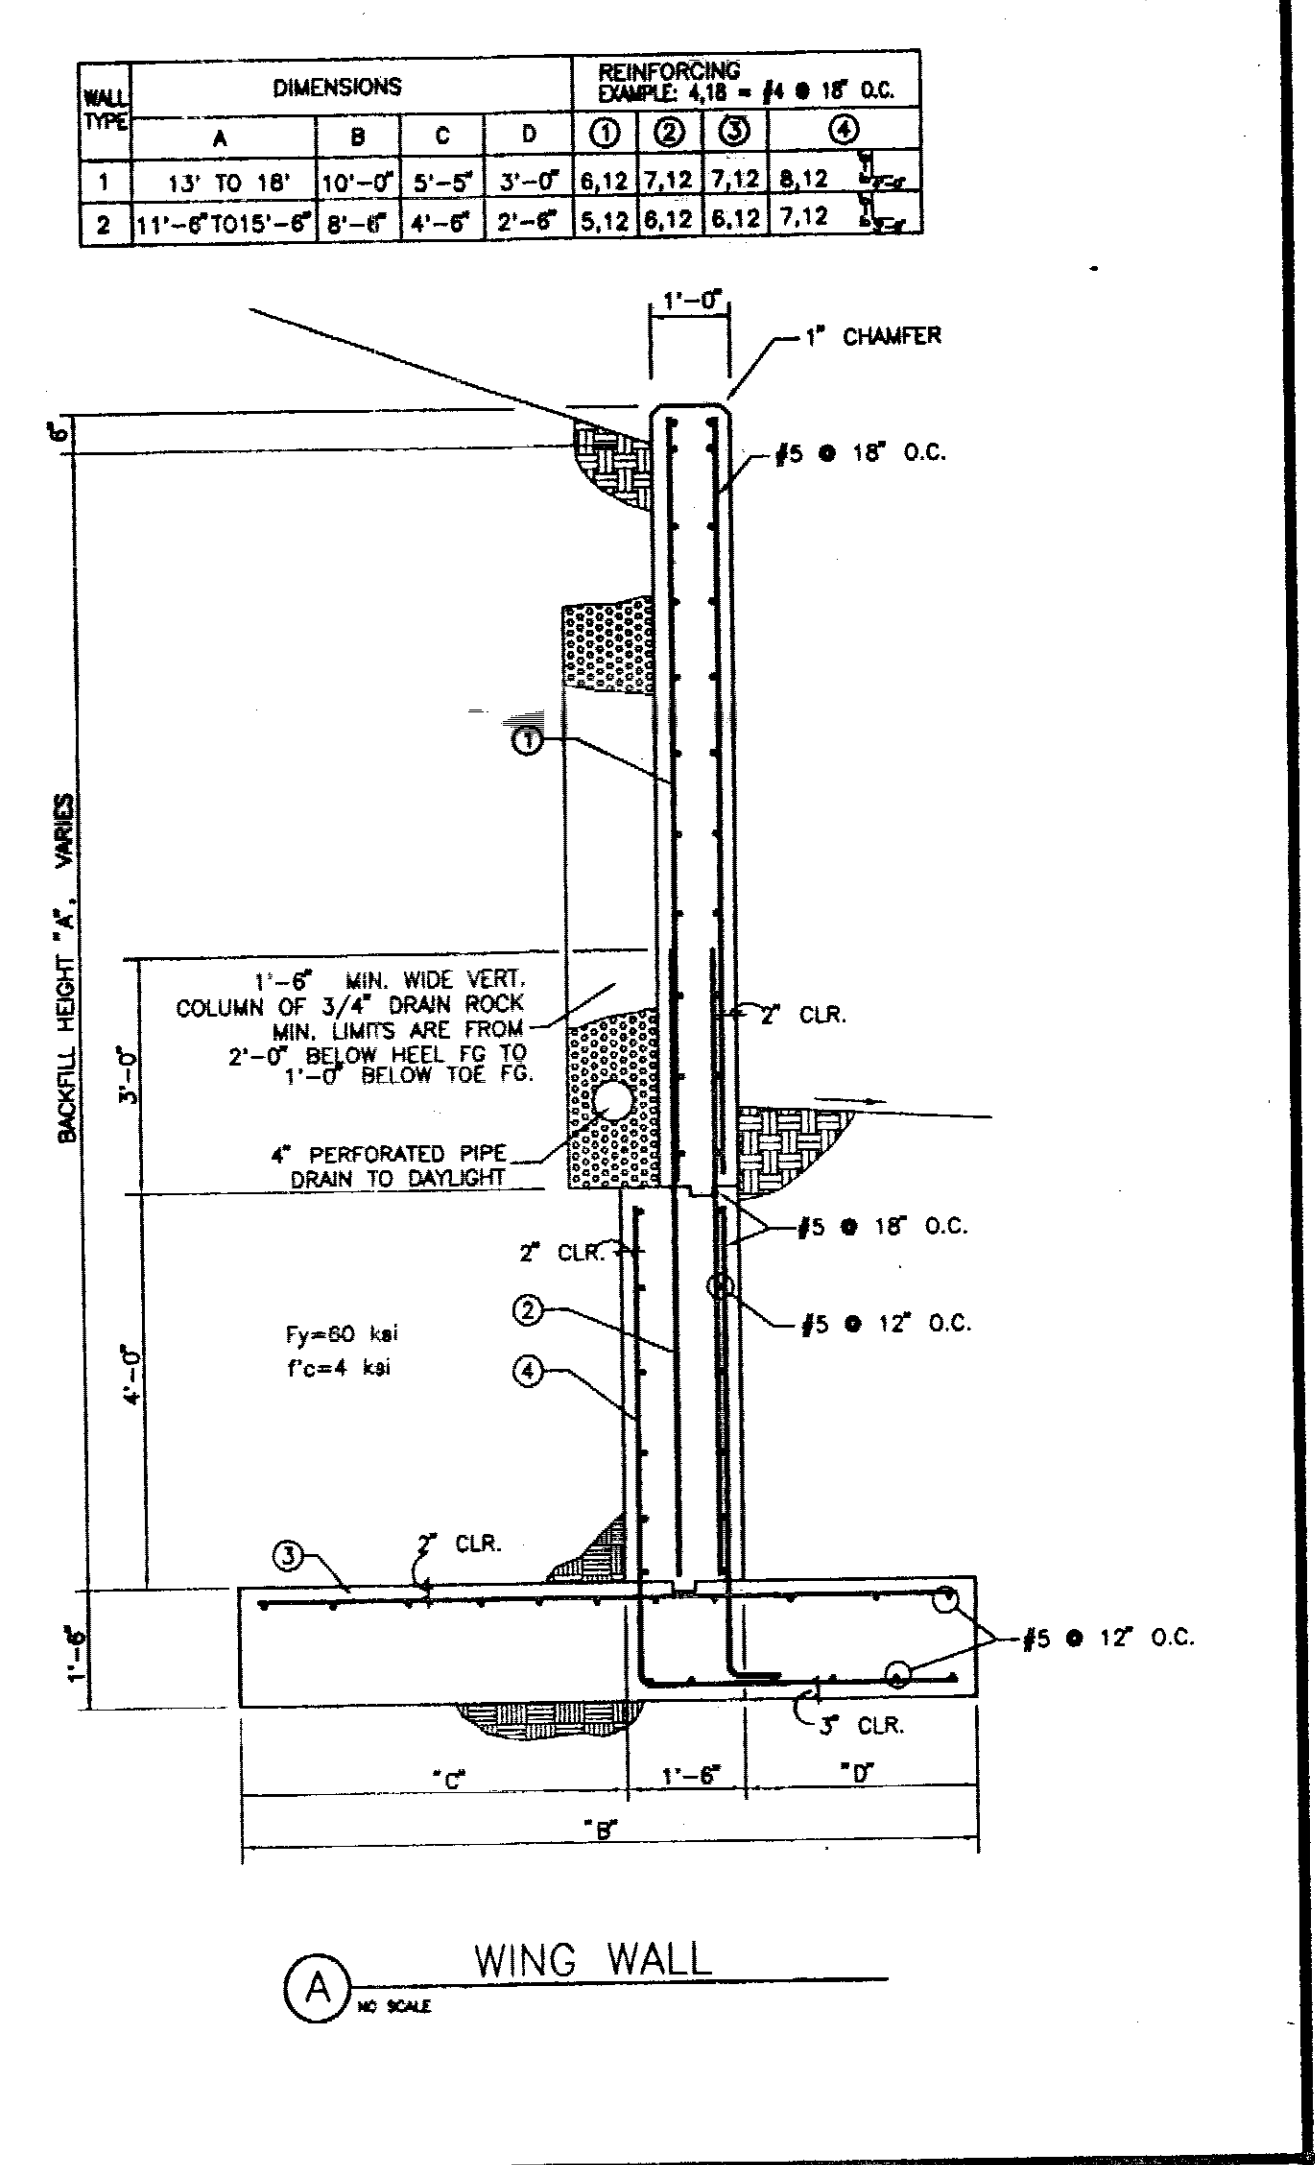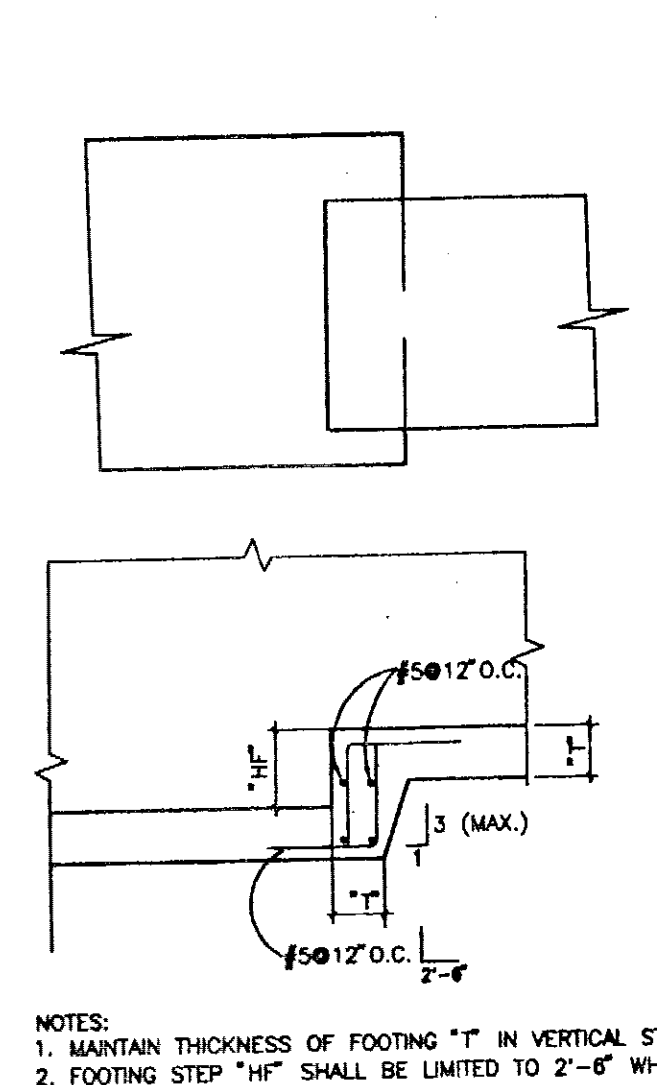

STATUS OF PLANS:

PRELIMINARY INITIAL SUBMITTAL FINAL SUBMITTAL

APPROVED BY WASHOE CO. ENG. DATE: 10/10/97

APPROVED BY WASHOE CO. UTIL. DATE: 10/10/97

LATEST REVISION APPROVED: YES NO

DATE: 12/15/97

RECORD DRAWINGS

THESE DRAWINGS ARE BASED ON INFORMATION PROVIDED BY THE CLIENT AND HAVE BEEN ADJUSTED TO REFLECT THE FIELD CONDITIONS. THESE PLANS IS ONLY GOOD AS FOR THESE CONDITIONS AND TO THE ACCURACY OF THE AS-BUILT INFORMATION.

04-05-99

DESIGNED BY: GS DATE SURVEYED: 4/10/97

DRAWN BY: OS DATE: 4/10/97

CHECKED BY: BGS DATE: 12/10/97

APPROVED BY: DATE: 12/10/97

REVISION TO C-SPAN HEIGHT.

PLANNERS: ENGINEERS: LANDSCAPE ARCHITECTS: SURVEYORS:

efaf 1150 CORPORATE BLVD. R.L. NV 89402 (702) 856 1100 FAX: (702) 856-1180

ARROWCREEK SAD # 23

PLAN / DETAILS


NEVADA

WASHOE COUNTY


JOB. NO. 88-00327

DATE: 9/12/97

SHEET 26 OF 29

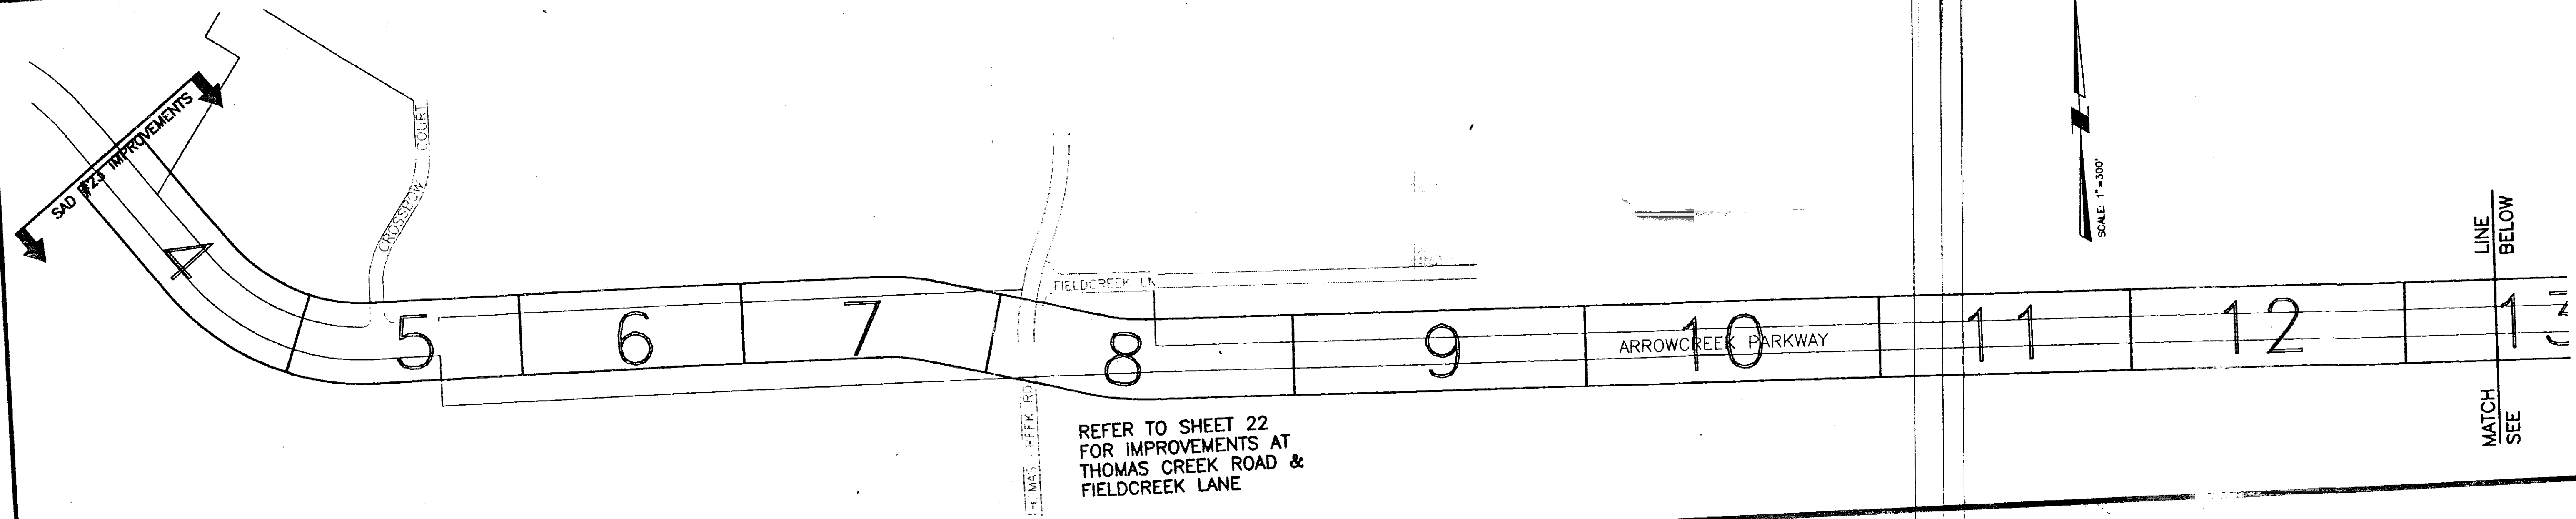


REFER TO SHEET 22
FOR IMPROVEMENTS AT
THOMAS CREEK ROAD &
FIELD CREEK LANE

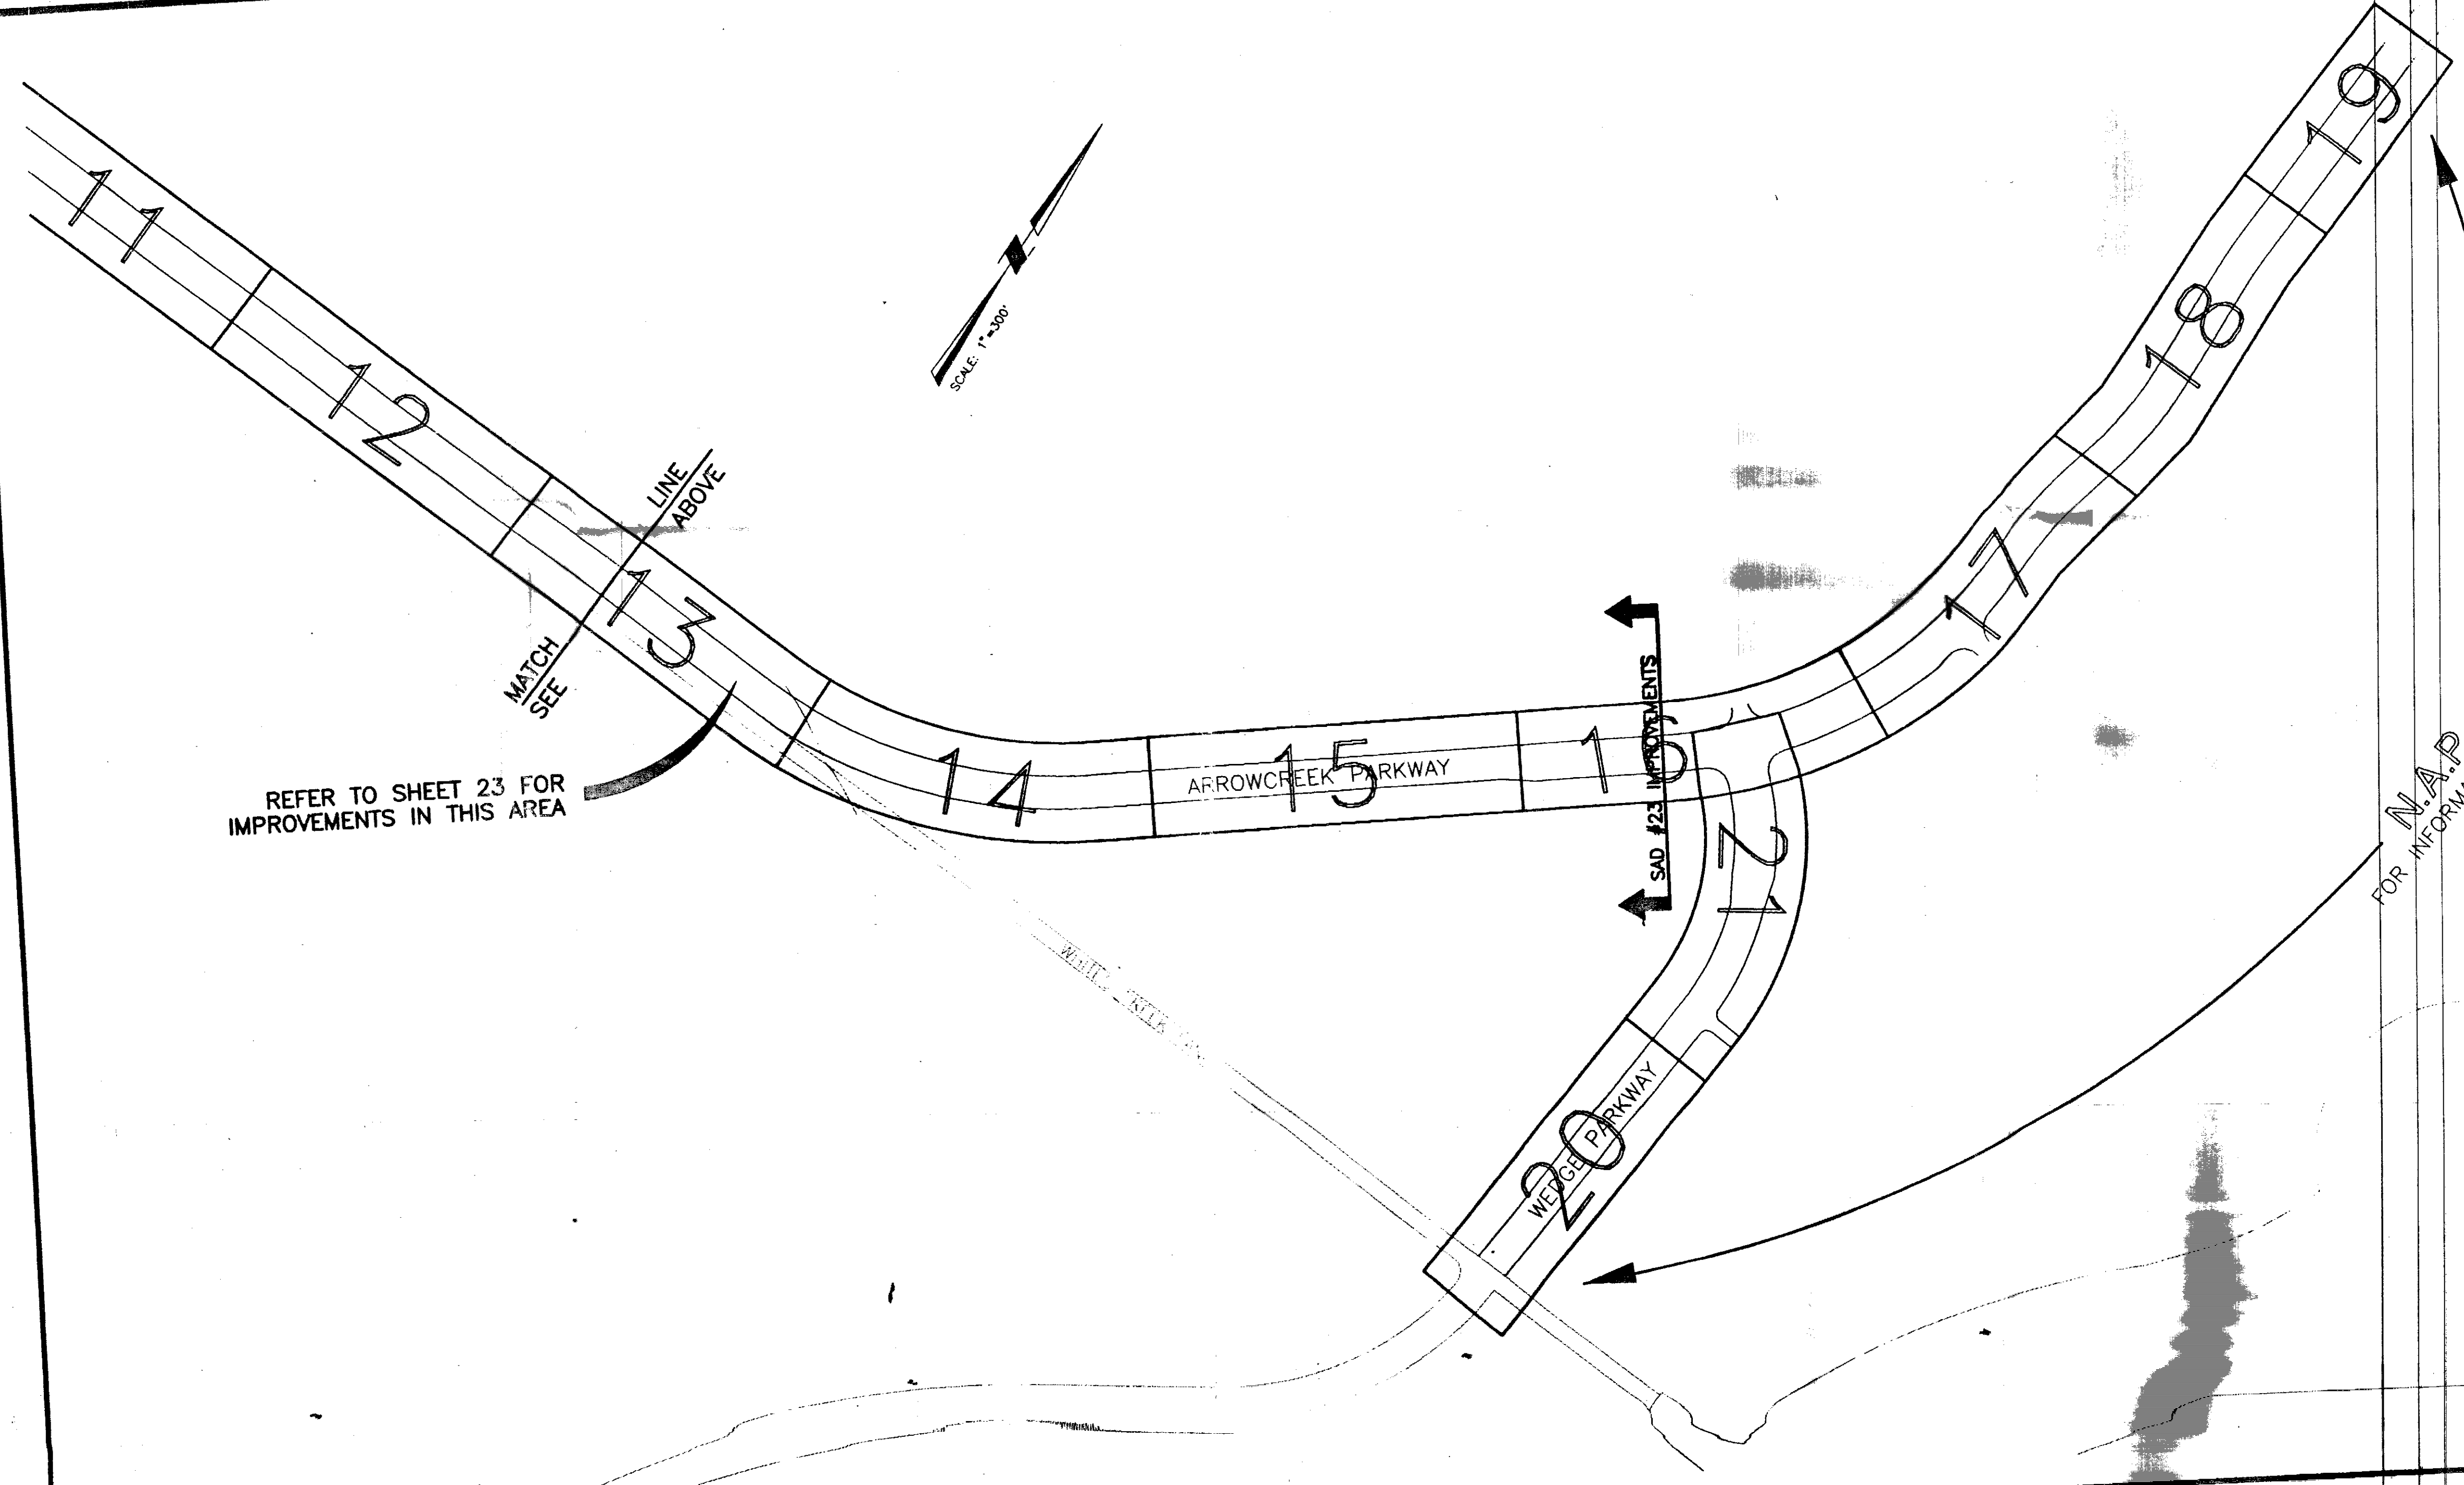

REFER TO SHEET 23 FOR
IMPROVEMENTS IN THIS AREA


RECORD DRAWINGS
THESE DRAWINGS ARE BASED ON INFORMATION PROVIDED TO CFA BY THE CONTRACTOR AND HAVE BEEN ADJUSTED TO REFLECT THESE CHANGES. THE ENGINEER BY STAMPING AND SIGNING THESE PLANS IS ONLY DOING SO FOR DESIGN PURPOSES. THERE ARE NO WARRANTIES OR GUARANTEES AS TO THE ACCURACY OF THE AS-BUILT INFORMATION.
04-05-99

STATUS OF PLANS	
<input type="checkbox"/> PRELIMINARY	DATE: _____
<input type="checkbox"/> INITIAL SUBMITTAL	DATE: _____
<input type="checkbox"/> FINAL SUBMITTAL	DATE: _____
<input checked="" type="checkbox"/> APPROVED BY WASHOE CO. ENG.	DATE: 10/10/97
<input checked="" type="checkbox"/> APPROVED BY WASHOE CO. UTIL.	DATE: 10/10/97
<input type="checkbox"/> LATEST REVISION	DATE: _____
APPROVED: YES <input type="checkbox"/> NO <input type="checkbox"/>	


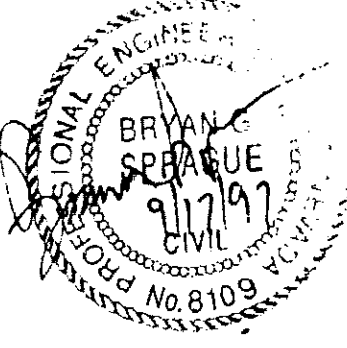


DESIGNED BY: CS	DATE SURVEYED: 4/10/97	cfa ENGINEERS ARCHITECTS 1150 CORPORATE BLVD., RENO, NV 89502 (702) 858-1150 FAX: (702) 858-1160 NEVADA WASHOE COUNTY
DRAWN BY: OS/AC	DATE: 4/10/97	
CHECKED BY: RCT	DATE: _____	
APPROVED BY: _____	DATE: _____	
ARROWCREEK SAD # 23 KEY SHEET		JOB NO: 98-003.27 DATE: 5/12/97 SHEET: 2 of 29

06/20/06
 Survey Data Only


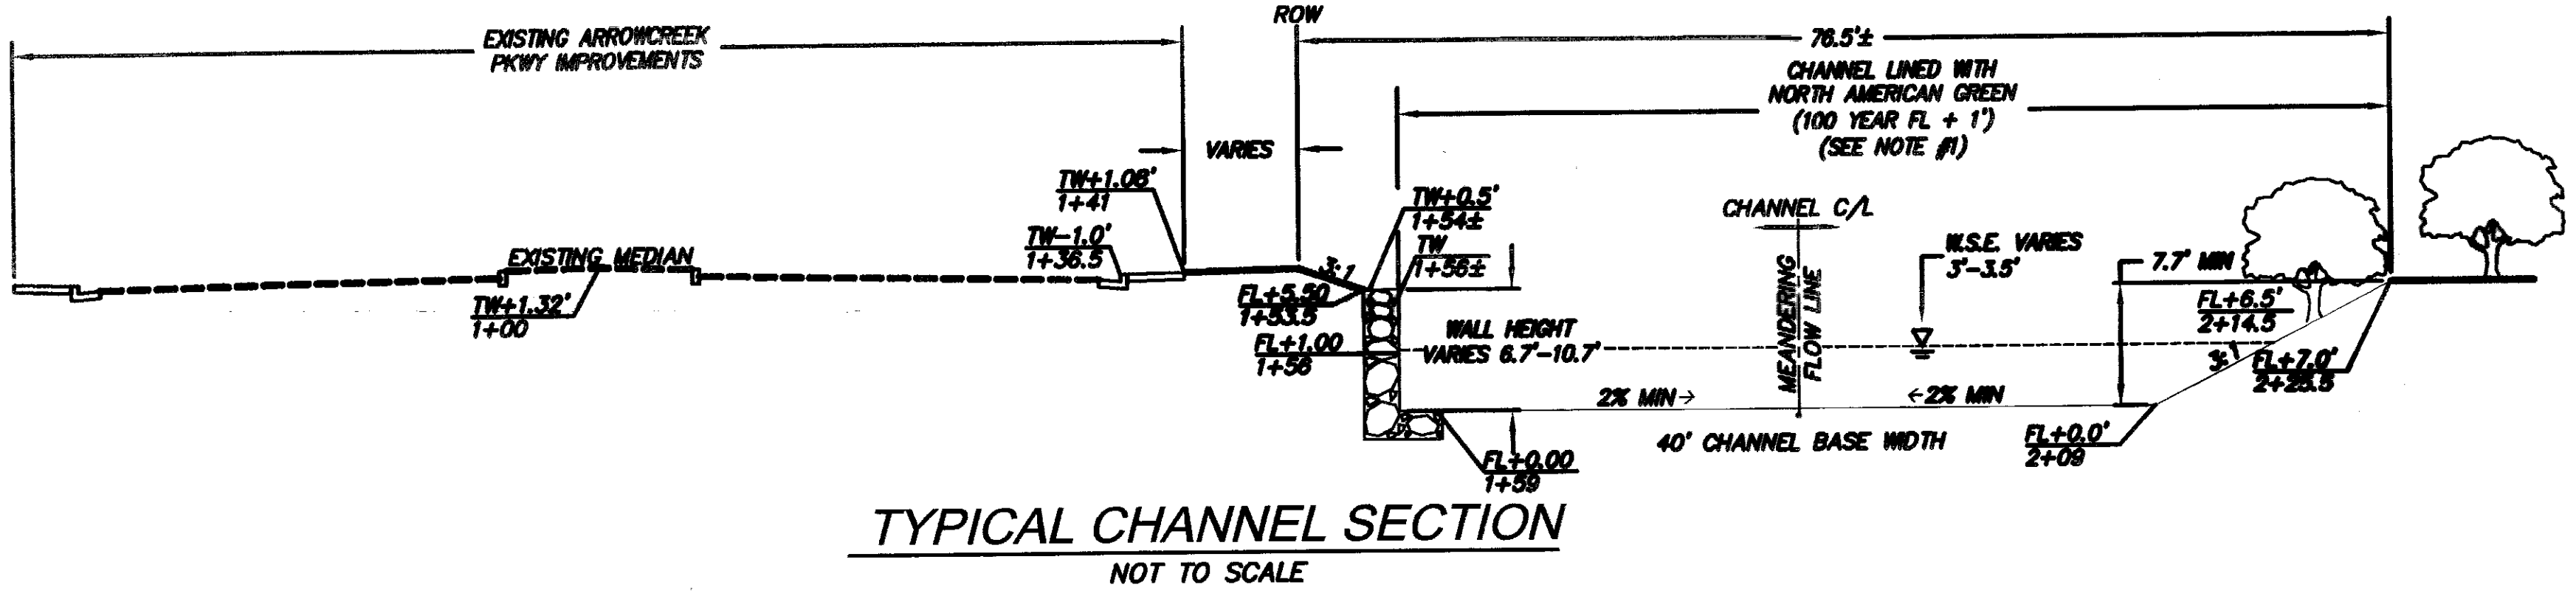


NOTE:
 CONC CAP AND RIPRAP GROUT TO BE
 COLORIZED PER TO MATCH HEADWALL
 COLORIZATION PER SPECIFICATIONS ON
 SHEET L15

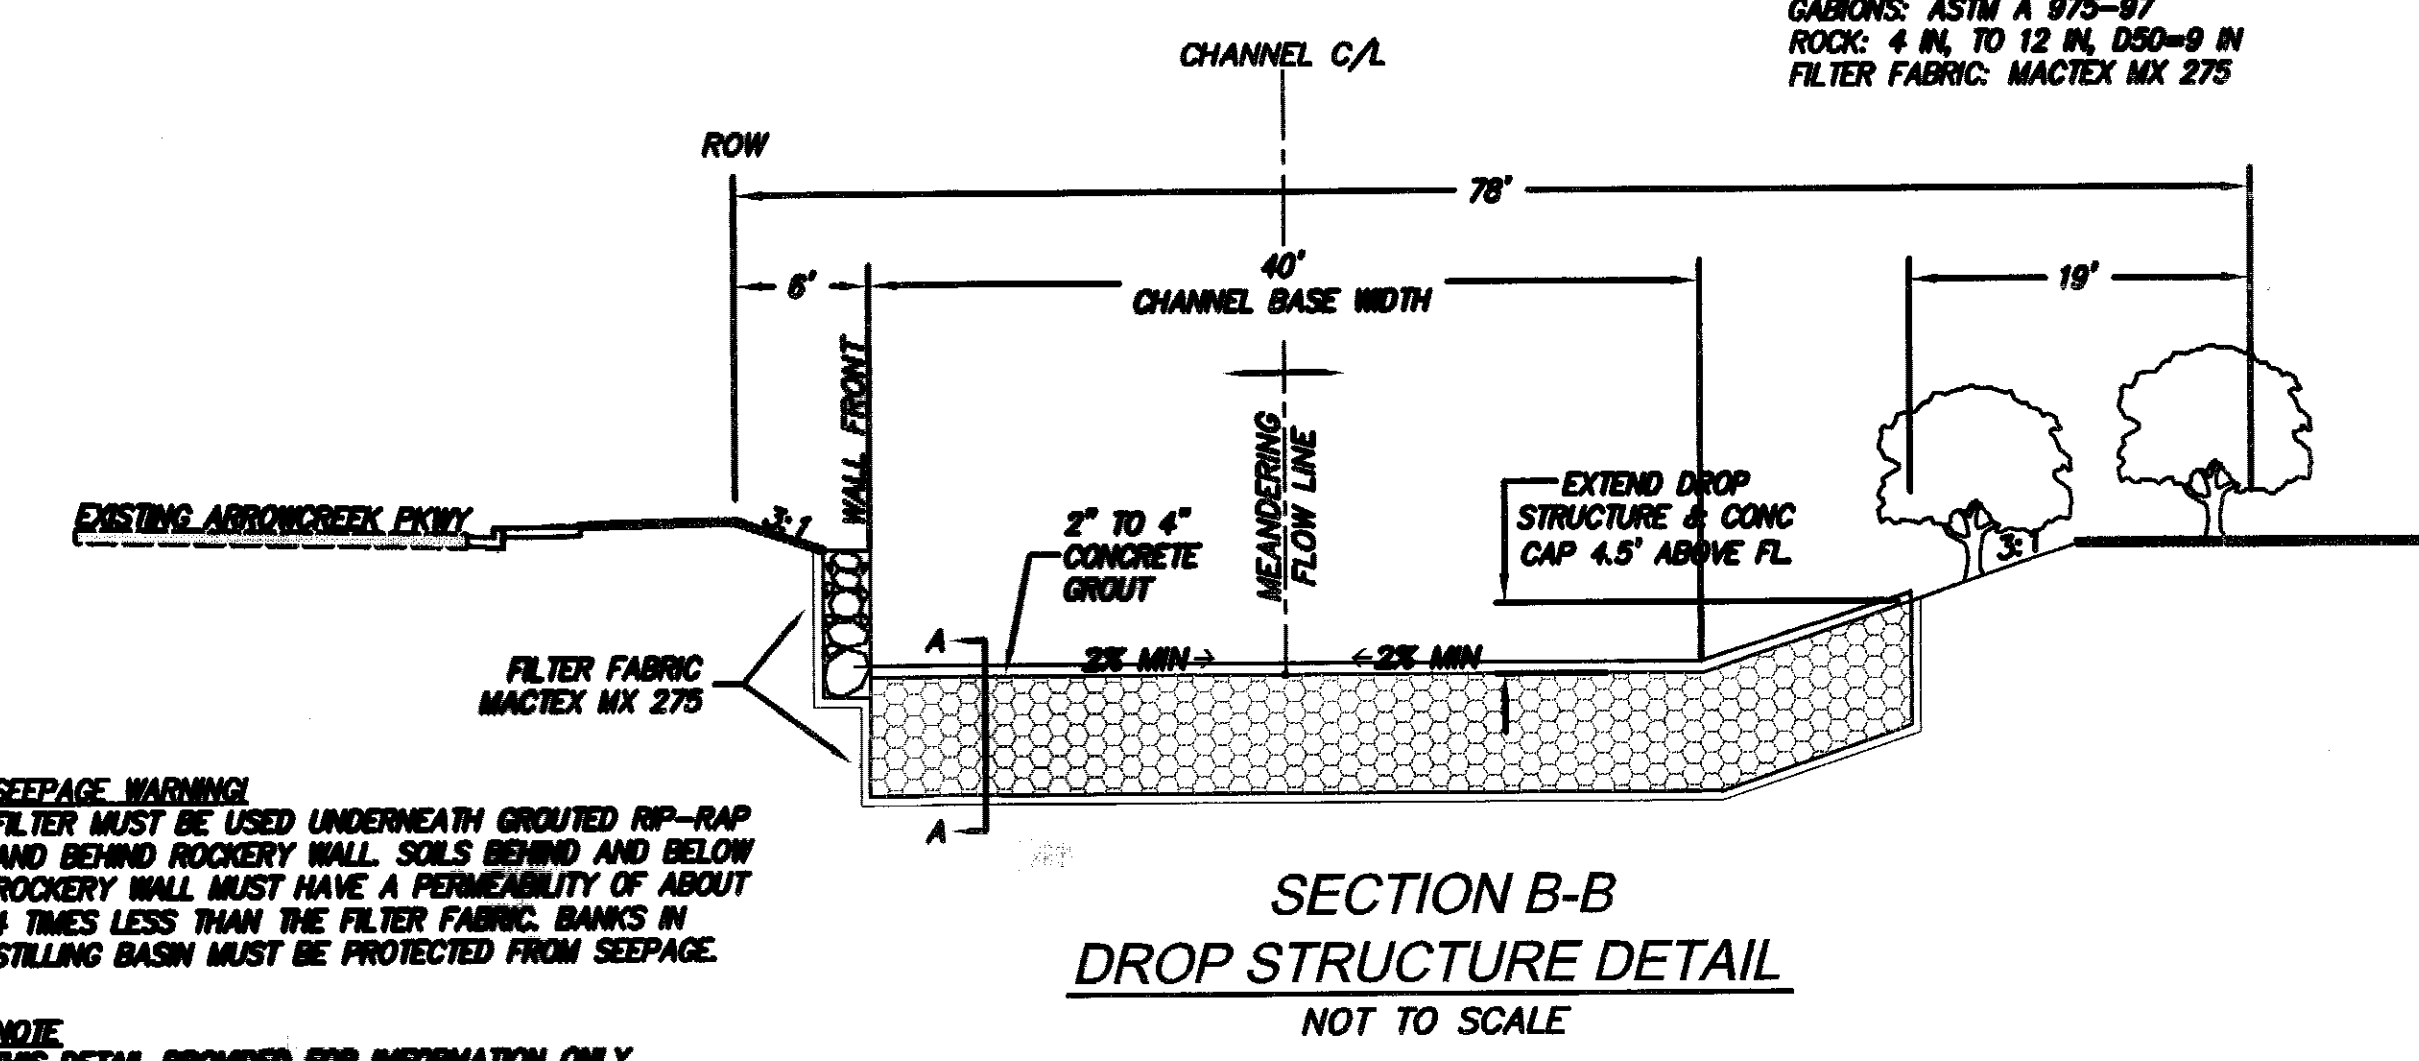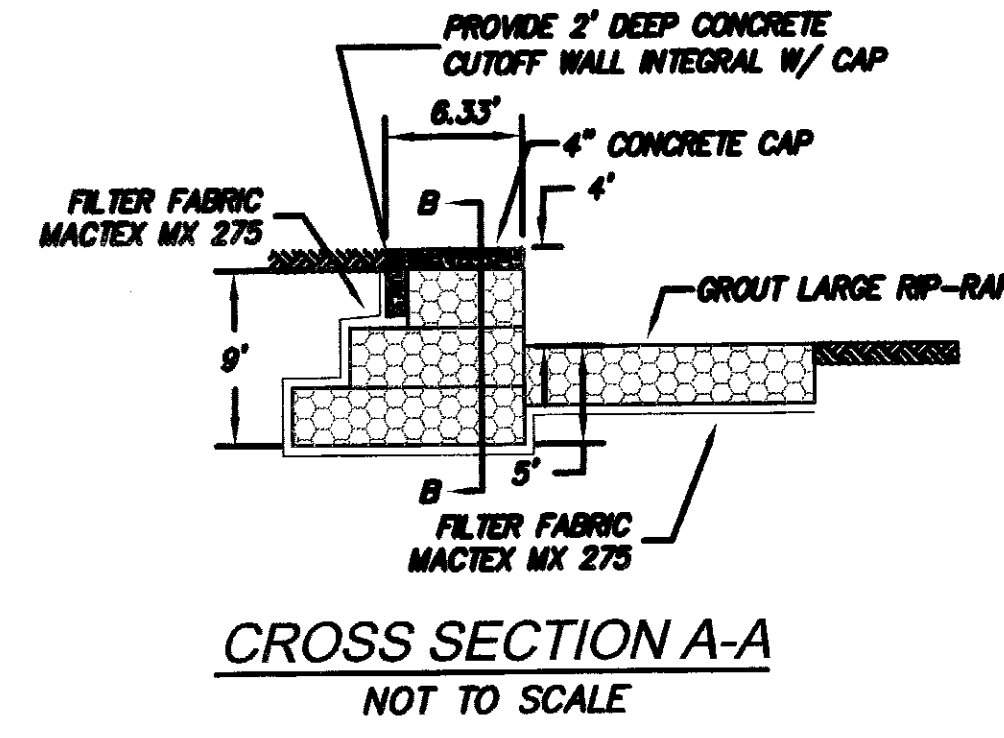

SEEPAGE WARNING:
 FILTER FABRIC MUST BE USED UNDERNEATH GROUTED RIP-RAP
 AND BEHIND ROCKERY WALL. SOILS BEHIND AND BELOW
 ROCKERY WALL MUST HAVE A PERMEABILITY OF ABOUT
 4 TIMES LESS THAN THE FILTER FABRIC. BANKS IN
 STILLING BASIN MUST BE PROTECTED FROM SEEPAGE.

NOTE:
 THIS DETAIL PROVIDED FOR INFORMATION ONLY.
 CONTRACTOR SHALL COORDINATE DROP STRUCTURE
 INSTALLATION DIRECTLY WITH MACCAFERRI, INC. @
 (908) 371-5805.

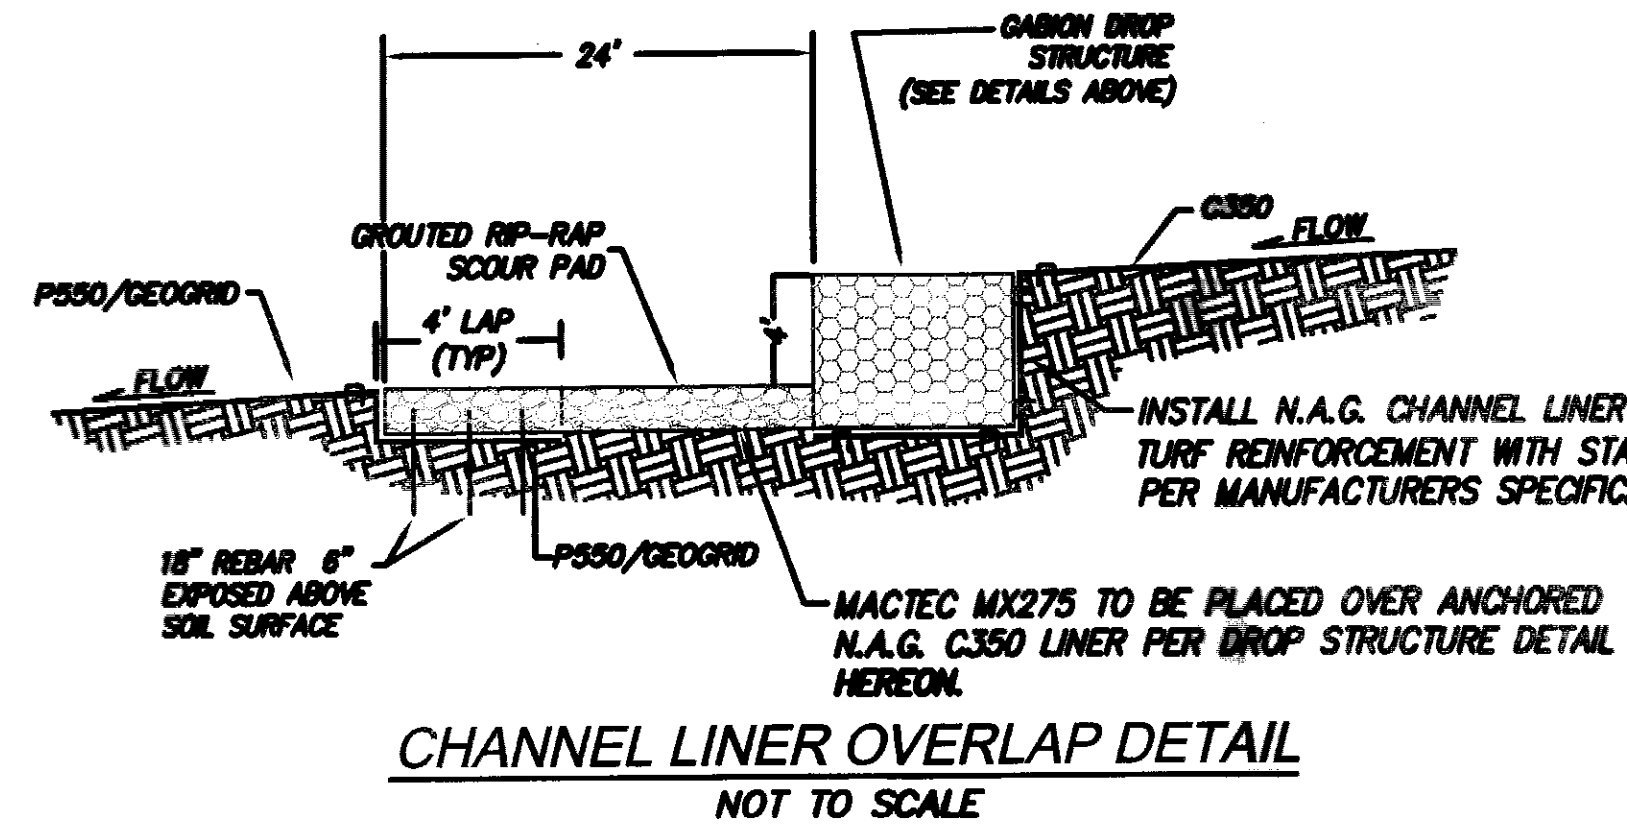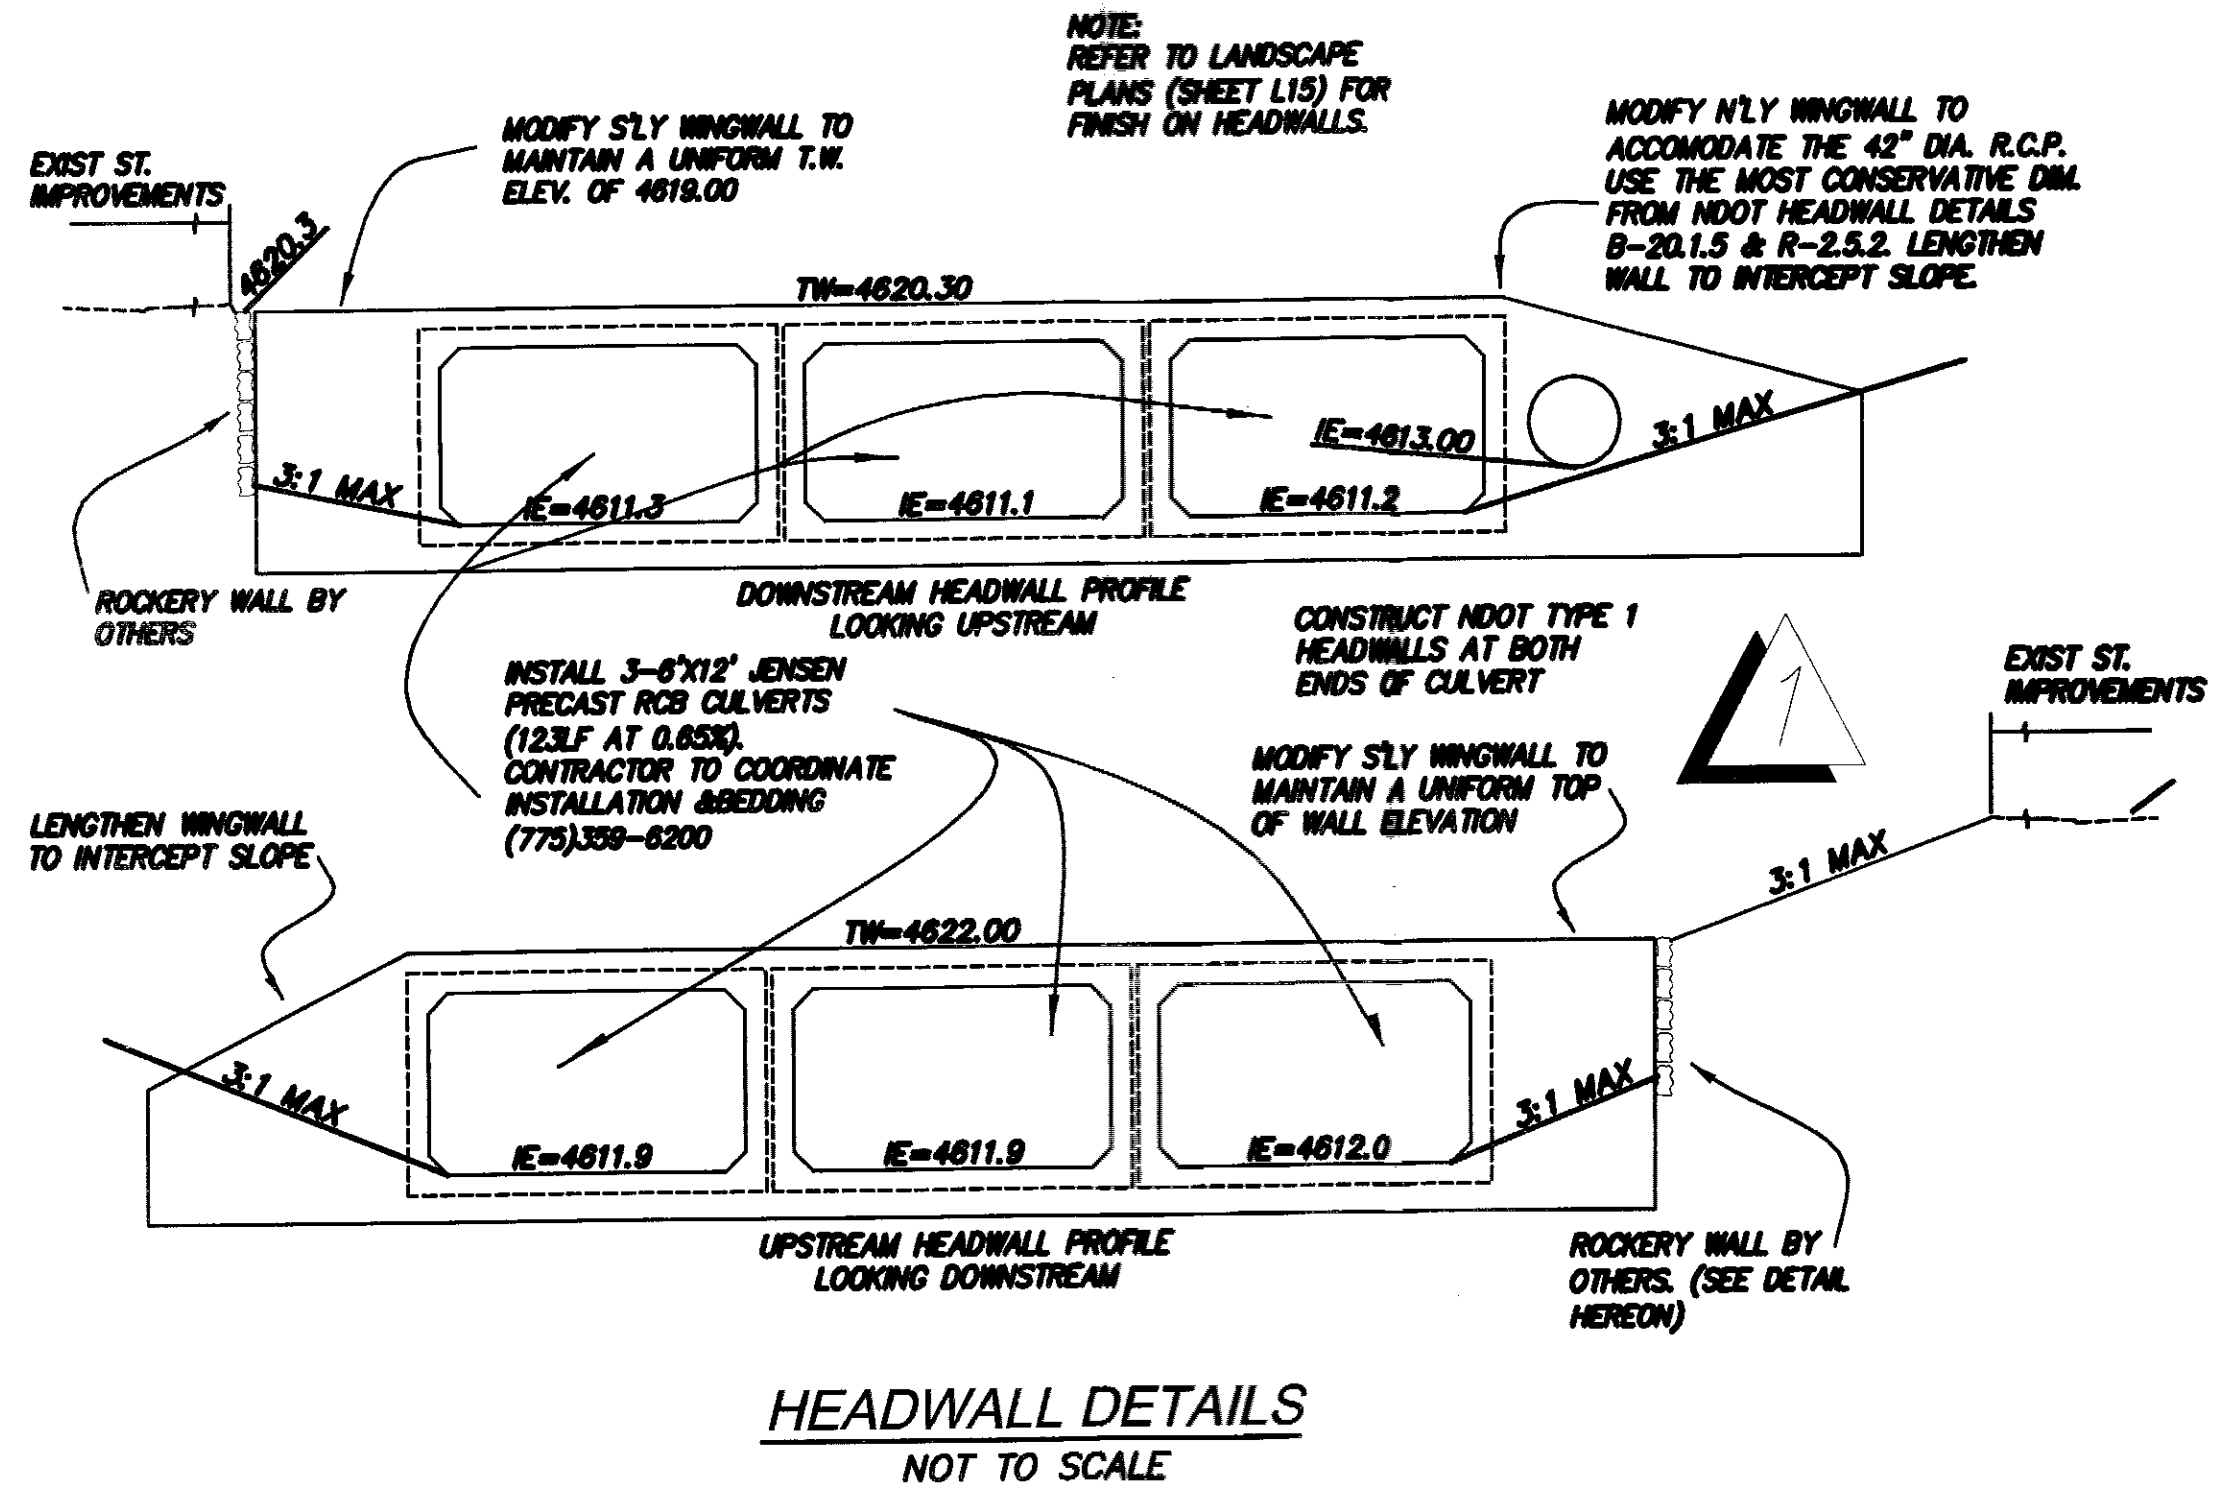

NOTE:
 FOR FURTHER INFORMATION ON:
 1. CHANNEL LINER (NAG P550) AND BIAXIAL GEOGRID
 (BX1500) - CONTACT NORTH AMERICAN GREEN
 AT (303) 765-1042
 2. GABION DROP STRUCTURES - CONTACT MACCAFERRI,
 INC. AT (916) 371-5805
 3. ROCKERY CHANNEL WALLS - CONTACT
 PEZONELLA ASSOCIATES @ (775) 856-5566

DATE: 06/20/06	DESIGNED BY: JLT	CHECKED BY: DWP
DATE: DECEMBER 2005	SCALE: NOT TO SCALE	NO.:
PROJECT NO. 060212	PROJECT NAME: PLAN FOR THE IMPROVEMENT OF AS-BUILT DETAILS	RENO, NEVADA
SHEET D1 OF D1	SEE TL FOR SHEET INDEX	

APPENDIX C

APPENDIX C

DETAILS